


1 LOCATION OF WATER WELL: County: WYANDOTTE Fraction SW 1/4 SW 1/4 SW 1/4 Section Number 6 Township Number T 11 S Range Number R 25 E/W

2 WATER WELL OWNER: AMOCO OIL COMPANY RR#, St. Address, Box #: 46 & STATE K.C., KS. Board of Agriculture, Division of Water Resources Application Number:

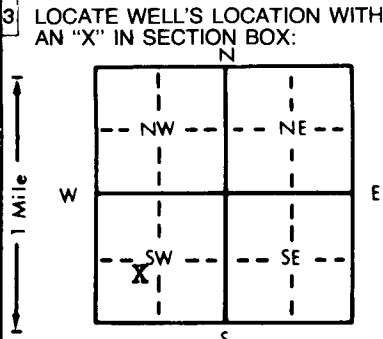

3 LOCATE WELL'S LOCATION WITH AN "X" IN SECTION BOX: 4 DEPTH OF COMPLETED WELL: 21 ft. ELEVATION: Depth(s) Groundwater Encountered 1. 18 ft. 2. ft. 3. ft. WELL'S STATIC WATER LEVEL 18 ft. below land surface measured on mo/day/yr 10/01/85

5 TYPE OF BLANK CASING USED: 1 Steel 3 RMP (SR) 5 Wrought iron 8 Concrete tile CASING JOINTS: Glued Clamped X Welded Threaded 2 PVC 4 ABS 7 Fiberglass 9 Other (specify below) Blank casing diameter 2 in. to ft., Dia. in. to ft., Dia. in. to ft. Casing height above land surface in., weight lbs./ft. Wall thickness or gauge No. SCH 40

6 GROUT MATERIAL: 1 Neat cement 2 Cement grout 3 Bentonite 4 Other CONCRETE 0 - 1 Grout Intervals: From 1 ft. to 10 ft., From ft. to ft., From ft. to ft. What is the nearest source of possible contamination: 1 Septic tank 4 Lateral lines 7 Pit privy 11 Fuel storage 14 Abandoned water well

Direction from well? EAST

FROM	TO	LITHOLOGIC LOG	FROM	TO	LITHOLOGIC LOG
0	1	BROWN CLAY			
1	22	GREEN CLAY			
	22	LIMESTONE			

7 CONTRACTOR'S OR LANDOWNER'S CERTIFICATION: This water well was (1) constructed, (2) reconstructed, or (3) plugged under my jurisdiction and was completed on (mo/day/year) 10/01/85 and this record is true to the best of my knowledge and belief. Kansas Water Well Contractor's License No. 468 This Water Well Record was completed on (mo/day/yr) 12/20/85 under the business name of J & R DRILLING SERVICES, INC. by (signature) Raymond Coors

INSTRUCTIONS: Use typewriter or ball point pen, PLEASE PRESS FIRMLY and PRINT clearly. Please fill in blanks, underline or circle the correct answers. Send top three copies to Kansas Department of Health and Environment, Division of Environment, Environmental Geology Section, Topeka, KS 66620. Send one to WATER WELL OWNER and retain one for your records.