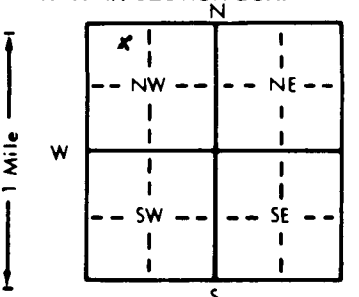


1 LOCATION OF WATER WELL: County: **WYANDOTTE** Fraction: **NW 1/4 NW 1/4 NW 1/4** Section Number: **7** Township Number: **T 11 S** Range Number: **R 25 (BW)**

Distance and direction from nearest town or city street address of well if located within city?
MONTGOMERY WARDS AUTO CENTER, INDIAN SPRINGS SHOPPING CENTER

2 WATER WELL OWNER: **K. S. CENTER LP**
 RR#, St. Address, Box #: **4601 STATE AV.** Board of Agriculture, Division of Water Resources
 City, State, ZIP Code: **KANSAS CITY, KS 66102** Application Number:

3 LOCATE WELL'S LOCATION WITH AN "X" IN SECTION BOX:


4 DEPTH OF COMPLETED WELL: **23.95** ft. ELEVATION: **GROUND SURFACE**
 Depth(s) Groundwater Encountered 1. **20** ft. 2. ft. 3. ft.
 WELL'S STATIC WATER LEVEL **20.01** ft. below land surface measured on mo/day/yr **6-18-92**
 Pump test data: Well water was ft. after hours pumping gpm
 Est. Yield gpm: Well water was ft. after hours pumping gpm
 Bore Hole Diameter: **8** in. to **24** ft., and in. to ft.
 WELL WATER TO BE USED AS: 5 Public water supply 8 Air conditioning 11 Injection well
 1 Domestic 3 Feedlot 6 Oil field water supply 9 Dewatering 12 Other (Specify below)
 2 Irrigation 4 Industrial 7 Lawn and garden only Monitoring well
 Was a chemical/bacteriological sample submitted to Department? Yes.....No.....; If yes, mo/day/yr sample was submitted
 Water Well Disinfected? Yes No

5 TYPE OF BLANK CASING USED:
 1 Steel 3 RMP (SR) 5 Wrought iron 8 Concrete tile CASING JOINTS: Glued Clamped
 PVC 4 ABS 6 Asbestos-Cement 9 Other (specify below) Welded
 7 Fiberglass Threaded **ASTM-F480**
 Blank casing diameter **2** in. to **9** ft., Dia in. to ft., Dia in. to ft.
 Casing height above land surface **1** in., weight lbs./ft. Wall thickness or gauge No. **SCH. 40**
 TYPE OF SCREEN OR PERFORATION MATERIAL: PVC 10 Asbestos-cement
 1 Steel 3 Stainless steel 5 Fiberglass 8 RMP (SR) 11 Other (specify)
 2 Brass 4 Galvanized steel 6 Concrete tile 9 ABS 12 None used (open hole)
 SCREEN OR PERFORATION OPENINGS ARE:
 1 Continuous slot Mill slot **0.010"** 5 Gauzed wrapped 8 Saw cut 11 None (open hole)
 2 Louvered shutter 4 Key punched 6 Wire wrapped 9 Drilled holes
 7 Torch cut 10 Other (specify)
 SCREEN-PERFORATED INTERVALS: From **9** ft. to **24** ft., From ft. to ft.
 From ft. to ft., From ft. to ft.
 GRAVEL PACK INTERVALS: From **7** ft. to **24** ft., From ft. to ft.
 From ft. to ft., From ft. to ft.

6 GROUT MATERIAL: 1 Neat cement Cement grout Bentonite 4 Other
 Grout Intervals (3) From **4** ft. to **7** ft. (2) From **0** ft. to **4** ft., From ft. to ft.
 What is the nearest source of possible contamination:
 1 Septic tank 4 Lateral lines 7 Pit privy 10 Livestock pens 14 Abandoned water well
 2 Sewer lines 5 Cess pool 8 Sewage lagoon 11 Fuel storage 15 Oil well/Gas well
 3 Watertight sewer lines 6 Seepage pit 9 Feedyard 12 Fertilizer storage Other (specify below)
EXCAVATED TANK PIT
 Direction from well? **N** How many feet? **32'**

FROM	TO	LITHOLOGIC LOG	FROM	TO	PLUGGING INTERVALS
0	0.5	CONCRETE			
0.5	2	SAND / GRAVEL BASE			
2	7	LT. RD. BRN SILTY CLAY w SAND			
7	8	GRAY TO BL SILTY CLAY			
8	13	RD. BRN SILTY CLAY			
13	13.2	LIMESTONE (FRACTURED)			
13.2	16	GRAY PLATY SHALE (WEATHERED)			
16	24	BRN + GRAY SHALE LAMINAR			
		LIMESTONE PARTINGS			
24		LIMESTONE (REFUSAL)			

7 CONTRACTOR'S OR LANDOWNER'S CERTIFICATION: This water well was constructed, (2) reconstructed, or (3) plugged under my jurisdiction and was completed on (mo/day/year) **6-18-92** and this record is true to the best of my knowledge and belief. Kansas Water Well Contractor's License No. **530** This Water Well Record was completed on (mo/day/yr) **6-30-92** under the business name of **SHAMROCK ENVIRONMENTAL DRILLING** by (signature) *Clay O. Nye*

OFFICE USE ONLY
T
R
EW
SEC
1/4
1/4