

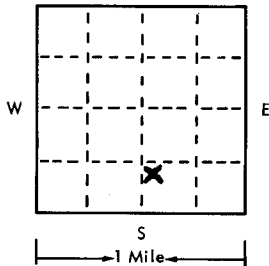
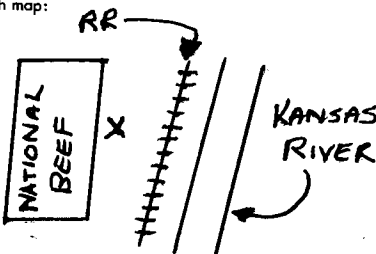
USE TYPEWRITER OR BALL  
POINT PEN-PRESS FIRMLY,  
PRINT CLEARLY.

WATER WELL RECORD  
KSA 82a-1201-1215

DCD?

T R EW sec 1/4 1/4 1/4 No.

Kansas State Dept. Of Health  
(Water Well Contractors)  
Forbes-Bldg. 740  
Topeka, Kansas 66620

|  |                            |                                  |   |                             |                           |   |  |
|--|----------------------------|----------------------------------|---|-----------------------------|---------------------------|---|--|
| 1 Location of well:  | County<br><b>WYANDOTTE</b> | Township name<br><b>DELEWARE</b> | Fraction<br><b>NW</b>   | Section number<br><b>10</b> | Town number<br><b>115</b> | Range number<br><b>25E</b>  |  |
| Distance and direction from nearest town or city: <b>KANSAS CITY, KANSAS</b>   |                            |                                  | 3 Owner of well: <b>CORP OF ENGINEERS</b>   |                             |                           |   |  |
| Street address of well location if in city: <b>WELL NO. 6 SYSTEM III 3RD &amp; CENTRAL</b>                             |                            |                                  | Address: <b>KANSAS CITY, MISSOURI</b>   |                             |                           |   |  |
| Locate with "X" in section below:<br> |                            |                                  | Sketch map:<br>  |                             |                           | 4 Well depth: <b>103</b> ft. Date of completion <b>3-27-75</b><br>Well diameter <b>30</b> in. |  |
| 2<br>Type and color of material  |                            |                                  | From  |                             | To                        |   |  |
|  |                            |                                  | BROWN SILT WITH CINDERS & BRICK   |                             | 0                         | 24  |  |
|  |                            |                                  | MEDIUM SAND (BROWN)   |                             | 24                        | 41  |  |
|  |                            |                                  | FINE SAND w/CLAY (BROWN)  |                             | 41                        | 55  |  |
|  |                            |                                  | CLAY (GRAY)   |                             | 55                        | 59  |  |
| MEDIUM SAND (GRAY)   |                            |                                  | 59  | 71                          |                           |   |  |
| CLAY (BROWN)   |                            |                                  | 71  | 74                          |                           |   |  |
| COARSE SAND (GRAY)   |                            |                                  | 74  | 95                          |                           |   |  |
| CLAY (GRAY)  |                            |                                  | 95  | 98                          |                           |   |  |
| COARSE SAND (GRAY)   |                            |                                  | 98  | 103                         |                           |   |  |
| (use a second sheet if needed)   |                            |                                  |   |                             |                           |   |  |
| 16 Remarks: elevation <b>755</b>   |                            |                                  | 17 Water well contractor's certification:<br>This well was drilled under my jurisdiction and this report is true to the best of my knowledge and belief.<br><b>LAYNE-WESTERN CO. INC. 149</b><br>Business name License No.<br>Address <b>1910 W. 39th</b><br>Signed <b>D. Allen</b> Date <b>4/1/75</b><br>Authorized representative |                             |                           |   |  |

Topography:  
☐ Hill  
☐ Slope  
☐ Upland  
☒ Valley