

22.

ART
R

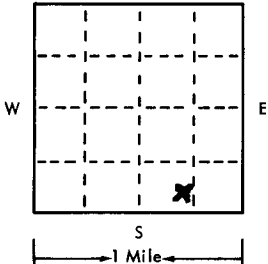
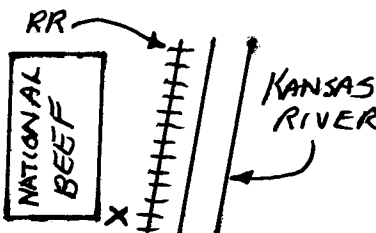
USE TYPEWRITER OR BALL
POINT PEN-PRESS FIRMLY,
PRINT CLEARLY.

WATER WELL RECORD
KSA 82a-1201-1215

T R EW sec 1/4 1/4 1/4 No.

Kansas State Dept. Of Health
(Water Well Contractors)
Forbes-Bldg. 740
Topeka, Kansas 66620

D C D 7
SE 1/4 SE 1/4

1 Location of well:	County WYANDOTTE	Township name DELEWARE	Fraction SE	Section number 10	Town number 115	Range number 25E
Distance and direction from nearest town or city: KANSAS CITY, KANSAS			3 Owner of well: CORP OF ENGINEERS			
Street address of well location if in city: WELL NO. 1 SYSTEM III 3RD & CENTRAL			Address: KANSAS CITY, MISSOURI			
Locate with "X" in section below: N  W E S 1 Mile		Sketch map: 		4 Well depth: 73 ft. Date of completion 12-11-74 Well diameter 30 in.		
2 Type and color of material		From		To		5 <input type="checkbox"/> Cable tool <input type="checkbox"/> Rotary <input type="checkbox"/> Driven <input type="checkbox"/> Dug <input type="checkbox"/> Hollow rod <input type="checkbox"/> Jetted <input type="checkbox"/> Bored <input checked="" type="checkbox"/> Reverse rotary
		SILTY CLAY WITH CINDERS & BRICKS		0 10		6 Use: <input type="checkbox"/> Domestic <input type="checkbox"/> Public supply <input type="checkbox"/> Industry <input type="checkbox"/> Irrigation <input type="checkbox"/> Air conditioning <input type="checkbox"/> Commercial <input type="checkbox"/> Test well <input checked="" type="checkbox"/> RELIEF
		FINE SAND (GRAY)		10 22		7 Casing: Material FABLS Height: above below Threaded <input type="checkbox"/> Welded <input type="checkbox"/> Surface <input type="checkbox"/> in. Diam. <input type="checkbox"/> Weight <input type="checkbox"/> lbs./ft. <input type="checkbox"/> 12 in. to 73 ft. depth Drive shoe? <input type="checkbox"/> Yes <input checked="" type="checkbox"/> No <input type="checkbox"/> in. to <input type="checkbox"/> ft. depth
		FINE SANDY SILT (GRAY)		22 27		8 Screen: Manufacturer FIBERGLASS RESOURCES Type SLOTTED Dia. 12 Slot/gauze 1/16 Length 18 Set between 68 ft. and 14 ft. Fittings: Gravel pack <input checked="" type="checkbox"/> Yes <input type="checkbox"/> No Size range of material 1/2
		MEDIUM TO FINE SAND (GRAY)		27 39		9 Static water level: 24 ft. below land surface Date 8-26-75
SILTY CLAY (GRAY)		39 46		10 Pumping level below land surfaces: 30.5 ft. after 4 hrs. pumping 200 g.p.m. ft. after <input type="checkbox"/> hrs. pumping <input type="checkbox"/> g.p.m. Estimated maximum yield 150 g.p.m.		
VERY FINE TO FINE SAND (GRAY)		46 65		11 Water sample submitted: <input type="checkbox"/> Yes <input checked="" type="checkbox"/> No Date <input type="checkbox"/>		
COARSE SAND (GRAY)		65 69		12 Well head completion: NO <input type="checkbox"/> Pitless adapter <input type="checkbox"/> Inches above grade		
WEATHERED LIMESTONE		69 73		13 Well grouted? <input checked="" type="checkbox"/> Yes <input type="checkbox"/> No <input type="checkbox"/> Neat cement <input type="checkbox"/> Bentonite <input checked="" type="checkbox"/> CONCRETE Depth: From 11 ft. to 6 ft.		
(use a second sheet if needed)				14 Nearest source of possible contamination: ft. <input type="checkbox"/> Direction <input type="checkbox"/> Type <input type="checkbox"/> Well disinfected upon completion? <input type="checkbox"/> Yes <input checked="" type="checkbox"/> No		
				15 Pump: NONE <input type="checkbox"/> Not installed Manufacturer's name <input type="checkbox"/> Model number <input type="checkbox"/> HP <input type="checkbox"/> Volts <input type="checkbox"/> Length of drop pipe <input type="checkbox"/> ft. capacity <input type="checkbox"/> g.m.p. Type: <input type="checkbox"/> Submersible <input type="checkbox"/> Turbine <input type="checkbox"/> Jet <input type="checkbox"/> Reciprocating <input type="checkbox"/> Centrifugal <input type="checkbox"/> Other		
16 Remarks: elevation 750 Topography: <input type="checkbox"/> Hill <input type="checkbox"/> Slope <input type="checkbox"/> Upland <input checked="" type="checkbox"/> Valley				17 Water well contractor's certification: This well was drilled under my jurisdiction and this report is true to the best of my knowledge and belief. LAYNE-WESTERN CO. INC 149 Business name License No. Address 1010 W. 39th ST. Signed [Signature] Date 6/1/76 Authorized representative		

Forward the white, blue and pink copies to the Kansas State Dept. Of Health.

Form WWC-5

BR = 681 $\frac{7}{2} = 726$