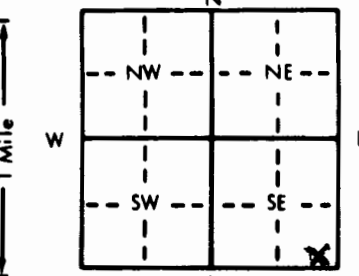


1 LOCATION OF WATER WELL:	Fraction	Section Number	Township Number	Range Number
County: <u>WYANDOTT</u>	<u>SE 1/4 SE 1/4 SE 1/4</u>	<u>10</u>	T <u>11</u> S	R <u>25</u> <u>EW</u>

Distance and direction from nearest town or city street address of well if located within city?  
300' West of Intersection of Central and Water Streets in Kansas City, KS

2 WATER WELL OWNER: P.L. Sharp & Associates (Contractor)	Board of Agriculture, Division of Water Resources
RR#, St. Address, Box #: 11850 West 85th Street	Application Number: <u>38,506</u>
City, State, ZIP Code: Lenexa, KS 66214	

3 LOCATE WELL'S LOCATION WITH AN "X" IN SECTION BOX:	4 DEPTH OF COMPLETED WELL: <u>75</u> ft. ELEVATION:
	WELL'S STATIC WATER LEVEL <u>20</u> ft. below land surface measured on mo/day/yr <u>2/2/87</u>
	WELL WATER TO BE USED AS:
	5 Public water supply 8 Air conditioning 11 Injection well
	1 Domestic 3 Feedlot 6 Oil field water supply <u>9 Dewatering</u> 12 Other (Specify below)
	2 Irrigation 4 Industrial 7 Lawn and garden only 10 Observation well
	Was a chemical/bacteriological sample submitted to Department? Yes <u>No</u> ; If yes, mo/day/yr sample was submitted
	Water Well Disinfected? Yes <u>No</u>

5 TYPE OF BLANK CASING USED:	5 Wrought iron	8 Concrete tile	CASING JOINTS: Glued <u>Clamped</u>
<u>1 Steel</u>	3 RMP (SR)	6 Asbestos-Cement	9 Other (specify below)
2 PVC	4 ABS	7 Fiberglass	10 Asbestos-cement
TYPE OF SCREEN OR PERFORATION MATERIAL:	5 Fiberglass	8 RMP (SR)	11 Other (specify)
<u>1 Steel</u>	3 Stainless steel	6 Concrete tile	9 ABS
2 Brass	4 Galvanized steel	5 Gauzed wrapped	8 Saw cut
SCREEN OR PERFORATION OPENINGS ARE:	3 Mill slot	6 Wire wrapped	9 Drilled holes
<u>1 Continuous slot</u>	4 Key punched	7 Torch cut	10 Other (specify)
2 Louvered shutter			

6 GROUT MATERIAL:	1 Neat cement	2 Cement grout	<u>3 Bentonite</u>	4 Other
What is the nearest source of possible contamination:	1 Septic tank	4 Lateral lines	7 Pit privy	10 Livestock pens
	2 Sewer lines	5 Cess pool	8 Sewage lagoon	11 Fuel storage
	3 Watertight sewer lines	6 Seepage pit	9 Feedyard	12 Fertilizer storage
Direction from well? <u>WELLS IN OLD FERRYMAN AREA</u>				13 Insecticide storage
				14 Abandoned water well
				15 Oil well/Gas well
				16 Other (specify below)

FROM	TO	LITHOLOGIC LOG	FROM	TO	LITHOLOGIC LOG
0	6	Brick & Cement Rubble			
6	16	Clay			
16	26	<del>XXX</del> Clay			
26	36	Clay			
36	46	F-M Grey Sand			
46	55	Clay			
55	60	Fine Grey Sand			
60	64	Clay			
64	68	Fine Grey Sand			
68	71	Clay			
71	74	Medium Grey Sand			
74	75	Clay			

7 CONTRACTOR'S OR LANDOWNER'S CERTIFICATION: This water well was <u>(1)</u> constructed, (2) reconstructed, or (3) plugged under my jurisdiction and was completed on (mo/day/year) <u>2/2/87</u> and this record is true to the best of my knowledge and belief. Kansas Water Well Contractor's License No. <u>429</u> This Water Well Record was completed on (mo/day/yr) <u>9/2/87</u> under the business name of <u>Stacon Construction Corporation</u> by (signature) <u>[Signature]</u>
---

INSTRUCTIONS: Use typewriter or ball point pen. PLEASE PRESS FIRMLY and PRINT clearly. Please fill in blanks, underline or circle the correct answers. Send to three copies to Kansas Department of Health and Environment, Bureau of Water Protection, Topeka, Kansas 66620-7320, Telephone: 913-862-9360. Send one to WATER WELL OWNER and retain one for your records.