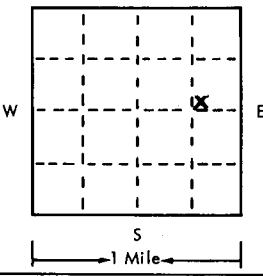
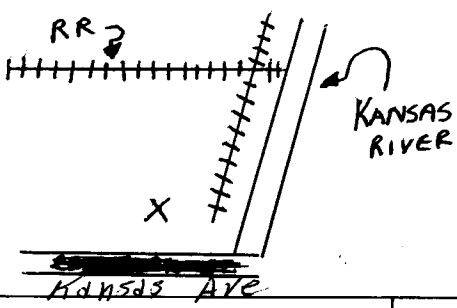


USE TYPEWRITER OR BALL
POINT PEN-PRESS FIRMLY,
PRINT CLEARLY.

WATER WELL RECORD
KSA 82a-1201-1215

T R EW sec 1/4 1/4 1/4 No.

Kansas State Dept. Of Health
(Water Well Contractors)
Forbes-Bldg. 740
Topeka, Kansas 66620

1 Location of well:	County WYANDOTTE	Township name DELEWARE	Fraction SW NE/SE	Section number 15	Town number 11.5	Range number 25 E
Distance and direction from nearest town or city: KANSAS CITY, KANSAS				3 Owner of well: CORPS OF ENGINEERS		
Street address of well location if in city: WELL NO. 1 SYSTEM II 1ST + 2ND KANS				Address: KANSAS CITY, MISSOURI		
Locate with "X" in section below: 				Sketch map: 		
2 Type and color of material				From	To	
BRICK AND CONCRETE				0	4	
MANURE				4	13	
SILTY CLAY (GRAY)				13	22	
MEDIUM TO COURSE SAND* (GRAY)				22	43	
SANDY CLAY (GRAY)				43	46	
COURSE SAND (GRAY)				46	50	
CLAY (GRAY)				50	53	
COURSE SAND w/BOULDERS (GRAY)				53	80	
(use a second sheet if needed)						
16 Remarks: elevation 748				17 Water well contractor's certification: This well was drilled under my jurisdiction and this report is true to the best of my knowledge and belief. LAYNE-WESTERN Co. 149 Business name License No. Address 1010 W 39TH ST Signed W. L. Lander Date 11/17/75 Authorized representative		
Topography: <input type="checkbox"/> Hill <input type="checkbox"/> Slope <input type="checkbox"/> Upland <input checked="" type="checkbox"/> Valley				11 25E 15 SW NE SE		