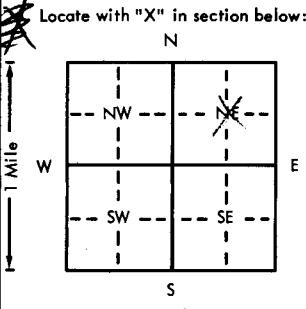
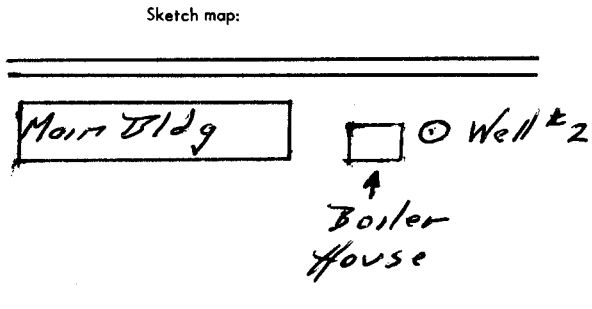
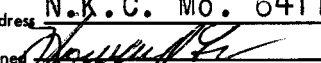


USE TYPEWRITER OR BALL
POINT PEN-PRESS FIRMLY,
PRINT CLEARLY.

WATER WELL RECORD
KSA 82a-1201-1215

Kansas Department of Health and
Environment-Division of Environment
(Water well Contractors)
Topeka, Kansas 66620

1. Location of well:	County WYANDOTTE	Fraction NE 1/4 NE 1/4 NE 1/4	Section number 19	Township number T 11 S R 25 E/W	Range number
2. Distance and direction from nearest town or city: Street address of well location if in city: 3601 KANSAS AVE.			3. Owner of well: FAIRBANKS MORSE PUMP DIV. R.R. or street: 3601 KANSAS AVE City, state, zip code: KANSAS CITY, KANSAS		
4. Locate with "X" in section below: 			Sketch map: 		
5. Type and color of material			From	To	6. Bore hole dia. 18 in. Completion date 10/13/76 Well depth 72 ft.
FILL			0	10	7. <input checked="" type="checkbox"/> Cable tool <input checked="" type="checkbox"/> Rotary <input type="checkbox"/> Driven <input type="checkbox"/> Dug <input type="checkbox"/> Hollow rod <input type="checkbox"/> Jetted <input type="checkbox"/> Bored <input type="checkbox"/> Reverse rotary
SAND, MED			10	20	8. Use: <input type="checkbox"/> Domestic <input type="checkbox"/> Public supply <input checked="" type="checkbox"/> Industry <input type="checkbox"/> Irrigation <input type="checkbox"/> Air conditioning <input type="checkbox"/> Stock <input type="checkbox"/> Lawn <input type="checkbox"/> Oil field water <input type="checkbox"/> Other
GREY SAND			20	30	9. Casing: Material STEEL Height: Above or below Threaded <input type="checkbox"/> Welded <input checked="" type="checkbox"/> Surface 18 in. RMP <input type="checkbox"/> PVC <input type="checkbox"/> Weight <input type="checkbox"/> lbs./ft. Dia. 8 in. to 62 ft. depth Wall Thickness: inches or Dia. <input type="checkbox"/> in. to <input type="checkbox"/> ft. depth gage No. 322
COARSE SAND			30	60	10. Screen: Manufacturer's name JOHNSON Type STAINLESS Dia. 8" Slot/gauze .050 Length 10' Set between 62 ft. and 72 ft. ft. and <input type="checkbox"/> ft. and <input type="checkbox"/> ft. Grovel pack? YES Size range of material 1/4x1/8
SAND & GRAVEL			60	72	11. Static water level: <input type="checkbox"/> mo./day/yr. 34 ft. below land surface Date 10/15/76
LIMESTONE			72		12. Pumping level below land surfaces: 48.8 ft. after 2 hrs. pumping 600 g.p.m. ft. after <input type="checkbox"/> hrs. pumping <input type="checkbox"/> g.p.m. Estimated maximum yield 850 g.p.m.
					13. Water sample submitted: <input type="checkbox"/> Yes <input checked="" type="checkbox"/> No Date <input type="checkbox"/> mo./day/yr.
					14. Well head completion: <input type="checkbox"/> Pitless adapter 18 Inches above grade
					15. Well grouted? YES With: <input checked="" type="checkbox"/> Neat cement <input type="checkbox"/> Bentonite <input type="checkbox"/> Concrete Depth: From 0 ft. to 15 ft.
					16. Nearest source of possible contamination: ft. Direction <input type="checkbox"/> Type <input type="checkbox"/> Well disinfected upon completion? <input type="checkbox"/> Yes <input type="checkbox"/> No
					17. Pump: <input type="checkbox"/> Not installed Manufacturer's name FAIRBANKS MORSE Model number 6M HP 25 Volts 160 Length of drop pipe 50 ft. capacity 600 g.p.m. Type: <input type="checkbox"/> Submersible <input checked="" type="checkbox"/> Turbine <input type="checkbox"/> Jet <input type="checkbox"/> Reciprocating <input type="checkbox"/> Centrifugal <input type="checkbox"/> Other
(Use a second sheet if needed)					
18. Elevation: 755 Topography: <input type="checkbox"/> Hill <input type="checkbox"/> Slope <input type="checkbox"/> Upland <input type="checkbox"/> Valley	19. Remarks:		20. Water well contractor's certification: This well was drilled under my jurisdiction and this report is true to the best of my knowledge and belief. CULLUM & BROWN INC 121 Business name Address N.K.C. Mo. 64116 License No. Signed  Date 9/1/77 Authorized representative		

Forward the white, blue and pink copies to the Department of Health and Environment

Form WWC-5