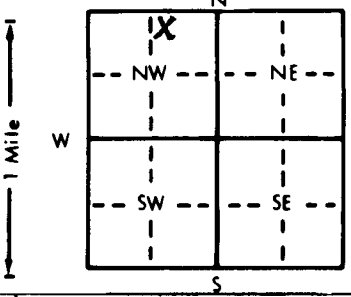


1 LOCATION OF WATER WELL:		Fraction	Section Number	Township Number	Range Number
County: Wyandotte		NW 1/4 NE 1/4 NW 1/4	20	T 11 S	R 25 EW
Distance and direction from nearest town or city street address of well if located within city? 3401 Fairbanks Kansas City, Kansas					
2 WATER WELL OWNER: ARCO Petroleum Products Company				ERM-3A Board of Agriculture, Division of Water Resources	
RR#, St. Address, Box #: 515 Flower Street				Application Number:	
City, State, ZIP Code: Los Angeles, California 90071					
3 LOCATE WELL'S LOCATION WITH AN "X" IN SECTION BOX:		4 DEPTH OF COMPLETED WELL: 39.5 ft. ELEVATION:			
		Depth(s) Groundwater Encountered 1. 30 ft. 2. ft. 3. ft.			
		WELL'S STATIC WATER LEVEL 30 ft. below land surface measured on mo/day/yr 5-3-94			
		Pump test data: Well water was ft. after hours pumping gpm			
		Est. Yield gpm: Well water was ft. after hours pumping gpm			
		Bore Hole Diameter 11 in. to 40.0 ft., and in. to ft.			
TYPE OF BLANK CASING USED:		CASING JOINTS: Glued Clamped			
1 Steel		5 Wrought iron	8 Concrete tile		Welded
2 PVC		3 RMP (SR)	9 Other (specify below)		Threaded X
4 ABS		6 Asbestos-Cement			
7 Fiberglass					
Blank casing diameter 4 in. to 24.5 ft., Dia in. to ft., Dia in. to ft.					
Casing height above land surface 24 in., weight lbs./ft. Wall thickness or gauge No. Sch 40					
TYPE OF SCREEN OR PERFORATION MATERIAL:		7 PVC			
1 Steel		3 Stainless steel	5 Fiberglass	8 RMP (SR)	11 Other (specify)
2 Brass		4 Galvanized steel	6 Concrete tile	9 ABS	12 None used (open hole)
SCREEN OR PERFORATION OPENINGS ARE:		5 Gauzed wrapped 8 Saw cut 11 None (open hole)			
1 Continuous slot		3 Mill slot	6 Wire wrapped	9 Drilled holes	
2 Louvered shutter		4 Key punched	7 Torch cut	10 Other (specify)	
SCREEN-PERFORATED INTERVALS:		From 39.5 ft. to 24.5 ft., From ft. to ft.			
GRAVEL PACK INTERVALS:		From 40.0 ft. to 22 ft., From ft. to ft.			
6 GROUT MATERIAL:		1 Neat cement 2 Cement grout 3 Bentonite 4 Other Bentonite Pellets 22.5'-22'			
Grout Intervals: From 20' ft. to 3' ft., From Concrete ft. to Surface ft., From ft. to ft.					
What is the nearest source of possible contamination:		10 Livestock pens 14 Abandoned water well			
1 Septic tank 4 Lateral lines 7 Pit privy 11 Fuel storage 15 Oil well/Gas well		12 Fertilizer storage 16 Other (specify below)			
2 Sewer lines 5 Cess pool 8 Sewage lagoon 13 Insecticide storage					
3 Watertight sewer lines 6 Seepage pit 9 Feedyard					
Direction from well? South		How many feet? + 200			
LITHOLOGIC LOG		PLUGGING INTERVALS			
FROM	TO			FROM	TO
0'	3'	Brown Sand Fine to Coarse			
3'	9'	Brown Silty Clay w/Sand			
9'	19'	Gray Silty Sand			
19'	25'	Brown Fine Sand			
25'	38'	Brown Fine to Coarse Sand			
7 CONTRACTOR'S OR LANDOWNER'S CERTIFICATION: This water well was (1) constructed, (2) reconstructed, or (3) plugged under my jurisdiction and was completed on (mo/day/year) 5/3/94 and this record is true to the best of my knowledge and belief. Kansas Water Well Contractor's License No. 510 This Water Well Record was completed on (mo/day/yr) 6/14/94 under the business name of MIKON Corporation by (signature) David J. Kramer					
INSTRUCTIONS: Use typewriter or ball point pen. PLEASE PRESS FIRMLY and PRINT clearly. Please fill in blanks, underline or circle the correct answers. Send top three copies to Kansas Department of Health and Environment, Bureau of Water, Topeka, Kansas 66620-0001. Telephone: 913-296-5545. Send one to WATER WELL OWNER and retain one for your records.					