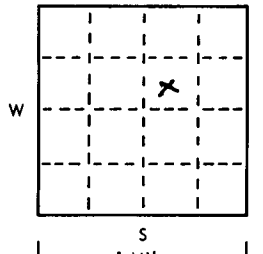
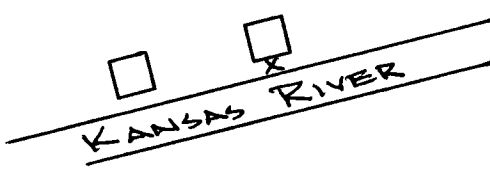


USE TYPEWRITER OR BALL
POINT PEN-PRESS FIRMLY,
PRINT CLEARLY.

WATER WELL RECORD
KSA 82a-1201-1215

T R EW sec 1/4 1/4 1/4 No.

Kansas State Dept. Of Health
(Water Well Contractors)
Forbes-Bldg. 740
Topeka, Kansas 66620

1 Location of well:	County WYANDOTTE	Township name DELEWARE	Fraction SW SW NE	Section number 22	Town number 115	Range number 25E	
Distance and direction from nearest town or city: K.L., KANSAS Street address of well location if in city: #5 SYSTEM I PACKARD & LUCILLE			3 Owner of well: CORP OF ENGINEERS Address: K.L. MISSOURI				
Locate with "X" in section below: 			Sketch map: MIDWEST COLD STORAGE 			4 Well depth: 87 ft. Date of completion 9/18/74 Well diameter 30 in.	
2 Type and color of material			From		To		
			SANDY SILT WITH CLAY, DEBRIS GRAY		0	18	
			SILTY CLAY BROWN		18	32	
			FINE SAND WITH SILT LAYERS GRAY		32	70	
			COARSE SAND		70	87	
					5 <input type="checkbox"/> Cable tool <input type="checkbox"/> Rotary <input type="checkbox"/> Driven <input type="checkbox"/> Dug <input type="checkbox"/> Hollow rod <input type="checkbox"/> Jetted <input type="checkbox"/> Bored <input checked="" type="checkbox"/> Reverse rotary		
					6 Use: <input type="checkbox"/> Domestic <input type="checkbox"/> Public supply <input type="checkbox"/> Industry <input type="checkbox"/> Irrigation <input type="checkbox"/> Air conditioning <input type="checkbox"/> Commercial <input type="checkbox"/> Test well <input checked="" type="checkbox"/> RELIEF		
					7 Casing: Material FEEL Height: above/below Threaded <input type="checkbox"/> Welded <input type="checkbox"/> Surface <input type="checkbox"/> in. Diam. 12 in. Weight 84 lbs./ft. 12 in. to 84 ft. depth Drive shoe? <input type="checkbox"/> Yes <input checked="" type="checkbox"/> No in. to ft. depth		
					8 Screen: Manufacturer: FIBERGLASS RESOURCE Type SLOTTED Dia. 12 Slot/gauze 1/16 Length 30 Set between 84 ft. and 40 ft. Fittings: Gravel pack <input checked="" type="checkbox"/> Yes <input type="checkbox"/> No Size range of material		
					9 Static water level: 36 ft. below land surface Date 7/17/75		
					10 Pumping level below land surfaces: 42 ft. after 4 hrs. pumping 320 g.p.m. ft. after hrs. pumping g.p.m. Estimated maximum yield 400 g.p.m.		
					11 Water sample submitted: <input type="checkbox"/> Yes <input checked="" type="checkbox"/> No Date		
					12 Well head completion: CUT OFF <input type="checkbox"/> Pitless adapter <input type="checkbox"/> Inches above grade		
					13 Well grouted? <input checked="" type="checkbox"/> Yes <input type="checkbox"/> No <input type="checkbox"/> Neat cement <input type="checkbox"/> Bentonite <input checked="" type="checkbox"/> CONCRETE Depth: From 717 ft. to 742 ft.		
					14 Nearest source of possible contamination: ft. Direction Type Well disinfected upon completion? <input type="checkbox"/> Yes <input checked="" type="checkbox"/> No		
					15 Pump: NONE <input type="checkbox"/> Not installed Manufacturer's name Model number HP Volts Length of drop pipe ft. capacity g.m.p. Type: <input type="checkbox"/> Submersible <input type="checkbox"/> Turbine <input type="checkbox"/> Jet <input type="checkbox"/> Reciprocating <input type="checkbox"/> Centrifugal <input type="checkbox"/> Other		
16 Remarks: elevation 754.8 Topography: <input type="checkbox"/> Hill <input type="checkbox"/> Slope <input type="checkbox"/> Upland <input checked="" type="checkbox"/> Valley			17 Water well contractor's certification: This well was drilled under my jurisdiction and this report is true to the best of my knowledge and belief Layne Western Co 149 Business name License No. Address 1810 W 39th KC MO Signed C. Anderson Date 6/17/76 Authorized representative				

Forward the white, blue and pink copies to the Kansas State Dept. Of Health.

Form WWC-5