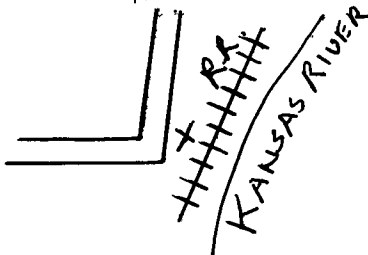


USE TYPEWRITER OR BALL
POINT PEN-PRESS FIRMLY,
PRINT CLEARLY.

WATER WELL RECORD
KSA 82a-1201-1215

T R EW sec 1/4 1/4 1/4 No.

Kansas State Dept. Of Health
(Water Well Contractors)
Forbes-Bldg. 740
Topeka, Kansas 66620

1 Location of well:	County WYANDOTTE	Township name DELEWARE	Fraction NE NIE	Section number 22	Town number 115	Range number 25E
Distance and direction from nearest town or city: K.C. KANSAS #11 SYSTEM I Street address of well location if in city: ADAMS & OSAGE			3 Owner of well: CORP. OF ENG. Address: K.C. MO.			
Locate with "X" in section below: N W E S 1 Mile			Sketch map: 			
2 Type and color of material			From	To	4 Well depth: 83 ft. Date of completion 9/23/74 Well diameter 30 in.	
SANDY SILT WITH CINDERS BRICK			0	23	5 <input type="checkbox"/> Cable tool <input type="checkbox"/> Rotary <input type="checkbox"/> Driven <input type="checkbox"/> Dug <input type="checkbox"/> Hollow rod <input type="checkbox"/> Jetted <input type="checkbox"/> Bored <input checked="" type="checkbox"/> Reverse rotary	
CLAY GRAY			23	27	6 Use: <input type="checkbox"/> Domestic <input type="checkbox"/> Public supply <input type="checkbox"/> Industry <input type="checkbox"/> Irrigation <input type="checkbox"/> Air conditioning <input type="checkbox"/> Commercial <input type="checkbox"/> Test well <input checked="" type="checkbox"/> RELIEF	
FINE SAND GRAY			27	41	7 Casing: Material FELS Height: above/below Threaded <input type="checkbox"/> Welded <input type="checkbox"/> Surface -10 in. Diam. _____ Weight _____ lbs./ft. _____ 12 in. to 38 ft. depth Drive shoe? <input type="checkbox"/> Yes <input checked="" type="checkbox"/> No _____ in. to _____ ft. depth	
SANDY SILT GRAY			41	48	8 Screen: Manufacturer FIBERGLASS RESOURCES Type SLOTTED Dia. 12" Slot/gauze 1/16" Length 25 Set between 78 ft. and 40 ft. _____ Fittings: Gravel pack <input checked="" type="checkbox"/> Yes <input type="checkbox"/> No Size range of material 1/2	
FINE SANDY CLAY GRAY			48	55	9 Static water level: 25 ft. below land surface Date 8/5/75	
CLAYEY SAND GRAY			55	60	10 Pumping level below land surfaces: 30 ft. after 4 hrs. pumping 480 g.p.m. _____ ft. after _____ hrs. pumping _____ g.p.m. Estimated maximum yield 500 g.p.m.	
COARSE SAND GRAY			60	83	11 Water sample submitted: <input type="checkbox"/> Yes <input checked="" type="checkbox"/> No Date _____	
					12 Well head completion: No <input type="checkbox"/> Pitless adapter <input type="checkbox"/> Inches above grade	
					13 Well grouted? <input checked="" type="checkbox"/> Yes <input type="checkbox"/> No <input type="checkbox"/> Neat cement <input type="checkbox"/> Bentonite <input type="checkbox"/> CONCRETE Depth: From 78 ft. to 31 ft.	
					14 Nearest source of possible contamination: ft. _____ Direction _____ Type _____ Well disinfected upon completion? <input type="checkbox"/> Yes <input checked="" type="checkbox"/> No	
					15 Pump: NONE <input type="checkbox"/> Not installed Manufacturer's name _____ Model number _____ HP _____ Volts _____ Length of drop pipe _____ ft. capacity _____ g.m.p. Type: <input type="checkbox"/> Submersible <input type="checkbox"/> Turbine <input type="checkbox"/> Jet <input type="checkbox"/> Reciprocating <input type="checkbox"/> Centrifugal <input type="checkbox"/> Other	
16 Remarks: elevation 752 Topography: <input type="checkbox"/> Hill <input type="checkbox"/> Slope <input type="checkbox"/> Upland <input checked="" type="checkbox"/> Valley			17 Water well contractor's certification: This well was drilled under my jurisdiction and this report is true to the best of my knowledge and belief. LAYNE - WESTERN 149 Business name _____ License No. _____ Address 1010 W 39TH KC. MO. Signed C. Allen Date 9/23/74 Authorized representative			