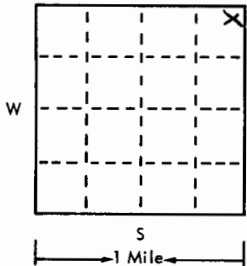
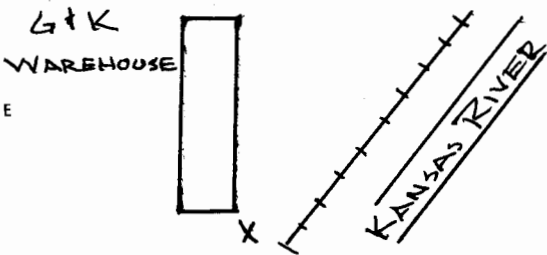


USE TYPEWRITER OR BALL
POINT PEN-PRESS FIRMLY,
PRINT CLEARLY.

WATER WELL RECORD
KSA 82a-1201-1215

T R EW sec 1/4 1/4 1/4 No.

Kansas State Dept. Of Health
(Water Well Contractors)
Forbes-Bldg. 740
Topeka, Kansas 66620

1 Location of well:	County WYANDOTTE	Township name DELEWARE	Fraction NE NE NE	Section number 22	Town number 11 S	Range number 25 E			
Distance and direction from nearest town or city: KANSAS CITY, KANSAS				Owner of well: LORD OF ENGINEERS					
Street address of well location if in city: #14 SYSTEM I SHAWNEE #RR				Address: KANSAS CITY, MISSOURI					
Locate with "X" in section below: N 		Sketch map: 		4 Well depth: 85 ft. Date of completion 3-13-1975 Well diameter _____ in.					
2		Type and color of material		From		To		5 ☐ Cable tool ☐ Rotary ☐ Driven ☐ Dug ☐ Hollow rod ☐ Jetted ☐ Bored ☒ Reverse rotary	
								6 Use: ☐ Domestic ☐ Public supply ☐ Industry ☐ Irrigation ☐ Air conditioning ☐ Commercial ☐ Test well ☒ RELIEF	
								7 Casing: Material FRGS Height: above /below Threaded ☐ Welded ☐ Surface -10 in FT Diam. _____ Weight _____ lbs./ft. _____ 12 in. to 29 ft. depth Drive shoe? ☐ Yes ☒ No _____ in. to _____ ft. depth	
								8 Screen: Manufacturer FIBERGLASS RESOURCE Type SLOTTED Dia. 12" Slot/gauze 1/16" Length 30 Set between 29 ft. and 33 ft. _____ Fittings: Gravel pack ☒ Yes ☐ No Size range of material 1/2	
(use a second sheet if needed)								9 Static water level: 26 ft. below land surface Date 9/8/75	
								10 Pumping level below land surfaces: 31 ft. after 4 hrs. pumping 200 g.p.m. _____ ft. after _____ hrs. pumping _____ g.p.m. Estimated maximum yield 600 g.p.m.	
								11 Water sample submitted: ☐ Yes ☒ No Date _____	
								12 Well head completion: NONE ☐ Pitless adapter ☐ Inches above grade	
								13 Well grouted? ☒ Yes ☐ No ☐ Neat cement ☐ Bentonite ☒ CONCRETE Depth: From 31 ft. to 18 ft.	
								14 Nearest source of possible contamination: ft. _____ Direction _____ Type _____ Well disinfected upon completion? ☐ Yes ☒ No	
								15 Pump: No ☐ Not installed Manufacturer's name _____ Model number _____ HP _____ Volts _____ Length of drop pipe _____ ft. capacity _____ g.m.p. Type: ☐ Submersible ☐ Turbine ☐ Jet ☐ Reciprocating ☐ Centrifugal ☐ Other	
								17 Water well contractor's certification: This well was drilled under my jurisdiction and this report is true to the best of my knowledge and belief. LATNE - WESTERN Co 149 Business name License No. Address 1010 W. 39TH ST. Signed P. Anderson Date 6/11/76 Authorized representative	
16 Remarks: elevation 253 Topography: ☐ Hill ☐ Slope ☐ Upland ☒ Valley									

Forward the white, blue and pink copies to the Kansas State Dept. Of Health.

Form WWC-5