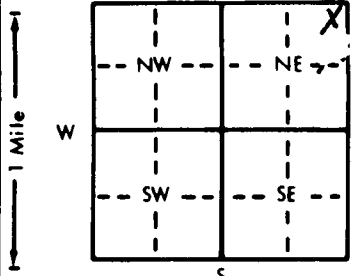


| | | | | |
|---|---|----------------------------|----------------------------------|---------------------------------------|
| 1 LOCATION OF WATER WELL: County: <u>Wyandotte</u> | Fraction <u>NE 1/4 NE 1/4 NE 1/4</u> | Section Number <u>3</u> | Township Number T <u>11</u> S | Range Number R <u>25</u> <u>EW</u> |
|---|---|----------------------------|----------------------------------|---------------------------------------|

Distance and direction from nearest town or city street address of well if located within city:

SE of Stewart & Water, W of KC Municipal Airport & Mo River

| | | |
|---|---|--|
| 2 WATER WELL OWNER: RR#, St. Address, Box # : City, State, ZIP Code : | <u>Darby Corp.</u> <u>1915 Water</u> <u>Kansas City, KS 66115</u> | Board of Agriculture, Division of Water Resources Application Number: |
|---|---|--|

| | |
|--|--|
| 3 LOCATE WELL'S LOCATION WITH AN "X" IN SECTION BOX:  | 4 DEPTH OF COMPLETED WELL: <u>40.0</u> ft. ELEVATION: Depth(s) Groundwater Encountered 1 <u>9.82</u> ft. 2 <u>40.0</u> ft. 3 <u>40.0</u> ft. WELL'S STATIC WATER LEVEL <u>9.82</u> ft. below land surface measured on mo/day/yr <u>4-27-95</u> Pump test data: Well water was <u>8</u> ft. after <u>4</u> hours pumping <u>40.0</u> gpm Est. Yield <u>40.0</u> gpm: Well water was <u>8</u> ft. after <u>4</u> hours pumping <u>40.0</u> gpm Bore Hole Diameter <u>8</u> in. to <u>8</u> in. and <u>8</u> in. to <u>8</u> in. WELL WATER TO BE USED AS: 5 Public water supply 8 Air conditioning 11 Injection well 1 Domestic 3 Feedlot 6 Oil field water supply 9 Dewatering 12 Other (Specify below) 2 Irrigation 4 Industrial 7 Lawn and garden only <u>10 Monitoring well</u> Was a chemical/bacteriological sample submitted to Department? Yes <u>No</u> If yes, mo/day/yr sample was submitted Water Well Disinfected? Yes <u>No</u> |
|--|--|

| | |
|--|---|
| 5 TYPE OF BLANK CASING USED: 1 Steel <u>2 PVC</u> 3 RMP (SR) 4 ABS Blank casing diameter <u>2</u> in. to <u>2</u> in. Dia <u>2</u> in. to <u>2</u> in. Dia <u>2</u> in. to <u>2</u> in. Casing height above land surface <u>4</u> in. weight <u>70</u> lbs./ft. Wall thickness or gauge No. <u>sch 40</u> | 5 Wrought iron 8 Concrete tile CASING JOINTS: Glued <u>Clamped</u> 6 Asbestos-Cement 9 Other (specify below) Welded <u>Threaded</u> 7 Fiberglass TYPE OF SCREEN OR PERFORATION MATERIAL: 1 Steel 3 Stainless steel 5 Fiberglass 8 RMP (SR) 11 Other (specify) 2 Brass 4 Galvanized steel 6 Concrete tile 9 ABS 12 None used (open hole) SCREEN OR PERFORATION OPENINGS ARE: 1 Continuous slot <u>3 Mill slot</u> 5 Gauzed wrapped 8 Saw cut 11 None (open hole) 2 Louvered shutter 4 Key punched 6 Wire wrapped 9 Drilled holes 10 Other (specify) 7 Torch cut SCREEN-PERFORATED INTERVALS: From <u>30.0</u> ft. to <u>40.0</u> ft. From <u>30.0</u> ft. to <u>40.0</u> ft. GRAVEL PACK INTERVALS: From <u>28.0</u> ft. to <u>40.0</u> ft. From <u>28.0</u> ft. to <u>40.0</u> ft. |
|--|---|

| | |
|---|---|
| 6 GROUT MATERIAL: Grout Intervals: From <u>28.0</u> ft. to <u>0.0</u> ft. From <u>0.0</u> ft. to <u>0.0</u> ft. From <u>0.0</u> ft. to <u>0.0</u> ft. From <u>0.0</u> ft. to <u>0.0</u> ft. What is the nearest source of possible contamination: 1 Septic tank 4 Lateral lines 7 Pit privy 10 Livestock pens 14 Abandoned water well 2 Sewer lines 5 Cess pool 8 Sewage lagoon 11 Fuel storage 15 Oil well/Gas well 3 Watertight sewer lines 6 Seepage pit 9 Feedyard 12 Fertilizer storage 16 Other (specify below) 13 Insecticide storage Direction from well? How many feet? | <u>1 Neat cement</u> <u>3 Bentonite</u> 4 Other |
|---|---|

| FROM | TO | LITHOLOGIC LOG | FROM | TO | PLUGGING INTERVALS |
|--|------|-------------------------|------|----|--------------------|
| 0.0 | 3.0 | Silty sand | | | |
| 3.0 | 5.0 | Sandy silt | | | |
| 5.0 | 17.0 | Clay | | | |
| 17.0 | 26.0 | Silty sand, some clay | | | |
| 26.0 | 30.0 | Sandy silt | | | |
| 30.0 | 33.0 | Clayey silt, trace sand | | | |
| 33.0 | 35.0 | Clay, trace silt | | | |
| 35.0 | 37.0 | Silty clay | | | |
| 37.0 | 40.0 | Limestone | | | |
| Allison Irwin contacted Don Taylor on 5-10-95 about forms being late | | | | | |

| |
|---|
| 7 CONTRACTOR'S OR LANDOWNER'S CERTIFICATION: This water well was <u>(1) constructed</u> , <u>(2) reconstructed</u> , or <u>(3) plugged</u> under my jurisdiction and was completed on (mo/day/year) <u>4-19-95</u> and this record is true to the best of my knowledge and belief. Kansas Water Well Contractor's License No. <u>531</u> This Water Well Record was completed on (mo/day/yr) <u>5-22-95</u> under the business name of <u>GSI</u> by (signature) <u>Allison Irwin</u> |
|---|