


USE TYPEWRITER OR BALL POINT PEN—PRESS FIRMLY, PRINT CLEARLY.

WATER WELL RECORD
KSA 820-1201-1215

Kansas Department of Health and Environment—Division of Environment (Water well Contractors)
Topeka, Kansas 66620

1. Location of well: County <u>Dickinson</u> Fraction <u>NW 1/4 NE 1/4 NE 1/4</u> Section number <u>28</u> Township number <u>T 11 S R 3</u> Range number <u>EW</u>	
2. Distance and direction from nearest town or city: <u>4 mile west 1 1/4 mile S of UPLAND</u> Street address of well location if in city: _____	
3. Owner of well: <u>Alice Luthi</u> R.R. or street: <u>1302 NW 2nd</u> City, state, zip code: <u>Abilene Kansas</u>	
4. Locate with "X" in section below: <div style="display: flex; align-items: center;"> <div style="margin-right: 20px;"> <p>Sketch map:</p> </div> <div> <p>6. Bore hole dia. <u>6 1/2</u> in. Completion date <u>1-16-76</u> Well depth <u>75</u> ft.</p> <p>7. <input checked="" type="checkbox"/> Cable tool <input type="checkbox"/> Rotary <input type="checkbox"/> Driven <input type="checkbox"/> Dug <input type="checkbox"/> Hollow rod <input type="checkbox"/> Jetted <input type="checkbox"/> Bored <input type="checkbox"/> Reverse rotary</p> <p>8. Use: <input checked="" type="checkbox"/> Domestic <input type="checkbox"/> Public supply <input type="checkbox"/> Industry <input type="checkbox"/> Irrigation <input type="checkbox"/> Air conditioning <input type="checkbox"/> Stock <input type="checkbox"/> Lawn <input type="checkbox"/> Oil field water <input type="checkbox"/> Other</p> <p>9. Casing: Material <u>PK</u> Height: <u>Above</u> or below Threaded <input type="checkbox"/> Welded <input checked="" type="checkbox"/> Surface <u>16</u> in. RMP <input checked="" type="checkbox"/> PVC <input type="checkbox"/> Weight _____ lbs./ft. Dia. <u>5</u> in. to <u>58</u> ft. depth Wall Thickness: inches or Dia. _____ in. to _____ ft. depth gage No. <u>1200</u></p> <p>10. Screen: Manufacturer's name <u>Jess & Lovel</u> Type <u>RMP</u> Dia. <u>5"</u> Slot/gauze <u>38</u> Length <u>17'</u> Set between <u>58</u> ft. and <u>75</u> ft. _____ ft. and _____ ft. Gravel pack? <u>NO</u> Size range of material: _____</p> <p>11. Static water level: _____ mo./day/yr. <u>58</u> ft. below land surface Date <u>1-16-76</u></p> <p>12. Pumping level below land surfaces: _____ ft. after _____ hrs. pumping _____ g.p.m. _____ ft. after _____ hrs. pumping _____ g.p.m. Estimated maximum yield <u>35</u> g.p.m.</p> <p>13. Water sample submitted: _____ mo./day/yr. Yes <input checked="" type="checkbox"/> No <input type="checkbox"/> Date _____</p> <p>14. Well head completion: <input type="checkbox"/> Pitless adapter <u>16</u> Inches above grade</p> <p>15. Well grouted? <input checked="" type="checkbox"/> With: <input type="checkbox"/> Neat cement <input type="checkbox"/> Bentonite <input checked="" type="checkbox"/> Concrete Depth: From <u>3</u> ft. to <u>14</u> ft.</p> <p>16. Nearest source of possible contamination: ft. <u>250</u> Direction <u>N</u> Type <u>Septic</u> Well disinfected upon completion? <input checked="" type="checkbox"/> Yes <input type="checkbox"/> No</p> <p>17. Pump: <input checked="" type="checkbox"/> Not installed Manufacturer's name _____ Model number _____ HP _____ Volts _____ Length of drop pipe _____ ft. capacity _____ g.p.m. Type: <input type="checkbox"/> Submersible <input type="checkbox"/> Turbine <input type="checkbox"/> Jet <input type="checkbox"/> Reciprocating <input type="checkbox"/> Centrifugal <input type="checkbox"/> Other</p> </div> </div>	
5. Type and color of material	
	From To
<u>Flinty Gravel - Little SOD</u>	<u>0</u> <u>2</u>
<u>Shale - Yellow</u>	<u>2</u> <u>10</u>
<u>Soft Lime - Yellow</u>	<u>10</u> <u>14</u>
<u>Shale - Green</u>	<u>14</u> <u>15</u>
<u>Red Rock - Red Rich</u>	<u>15</u> <u>37</u>
<u>Red Rock - Red - Pale</u>	<u>37</u> <u>44</u>
<u>LIME - Gray</u>	<u>44</u> <u>50</u>
<u>Shale & Broken Lime Yellow</u>	<u>50</u> <u>56</u>
<u>Shale - Yellow</u>	<u>56</u> <u>57</u>
<u>Broken Lime - Brn</u> <u>58 H2O</u>	<u>57</u> <u>58</u>
<u>Gray Shale - Gray</u>	<u>58</u> <u>60</u>
<u>LIME - Gray</u>	<u>60</u> <u>63</u>
<u>Shale - Pale Blu</u>	<u>63</u> <u>68</u>
<u>LIME - Gray</u>	<u>68</u> <u>75</u>
(Use a second sheet if needed)	
18. Elevation: _____	19. Remarks: <u>Concrete slab to be installed by Plumber</u> <u>X Ernest Pump & Plbg</u> <u>Ernest Gulbush</u>
20. Water well contractor's certification: This well was drilled under my jurisdiction and this report is true to the best of my knowledge and belief. <u>Zinn Water Well Drilling 218</u> Business name _____ License No. _____ Address <u>Lost Springs, Kan</u> Signed <u>Joseph A. Zinn</u> Date <u>1-20-76</u> Authorized representative	

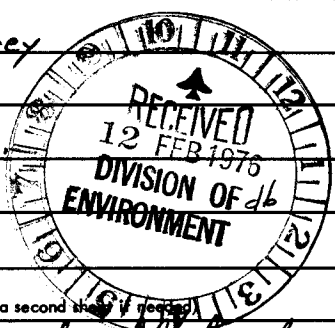

1-1-3-0-28
 T
 R
 W
 E
 Sec
 1/4 1/4 1/4 1/4
 NINE NE