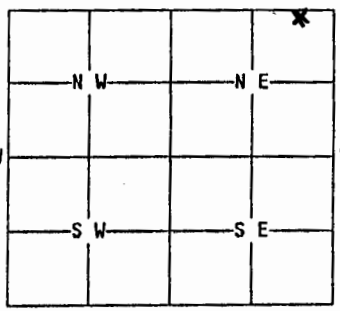


1 LOCATION OF WATER WELL:	Fraction	Section Number	Township Number	Range Number
County: <u>Dickinson</u>	<u>NE1/4 NE1/4 NE1/4</u>	<u>35</u>	<u>11 S</u>	<u>3 E</u>

Distance and direction from nearest town or city street address of well if located within city?

2.25 miles west and 2 miles south of Upland

2 WATER WELL OWNER: <u>Doug Caldwell</u>	RR#, St. Address, Box #: <u>1578 2800 Ave</u>
City, State, ZIP Code: <u>Abilene KS 67410</u>	Board of Agriculture, Division of Water Resources Application Number:

3 MARK WELL'S LOCATION WITH AN "X" IN SECTION BOX: N  S	4 DEPTH OF WELL..... <u>42</u>ft. WELL'S STATIC WATER LEVEL..... <u>15</u>ft. WELL WAS USED AS: <input checked="" type="radio"/> Domestic 5 Public Water Supply 9 Dewatering 2 Irrigation 6 Oil Field Water Supply 10 Monitoring Well 3 Feedlot 7 Lawn and Garden Only 11 Injection Well 4 Industrial 8 Air Conditioning 12 Other..... Was a chemical/bacteriological sample submitted to Department? Yes.... <u>No</u> ... If yes, mo/day/yr sample was submitted..... Water Well Disinfected: Yes. <u>X</u> . No.....
---	--

5 TYPE OF BLANK CASING USED:	
<input checked="" type="radio"/> 1 Steel 3 RMP (SR) 5 Wrought 7 Fiberglass 9 Other (specify below) <input checked="" type="radio"/> 2 PVC 4 ABS 6 Asbestos-Cement 8 Concrete Tile	
Blank casing diameter... <u>5.5</u> ...in.	Was casing pulled? Yes... <u>X</u> ... No..... If yes, how much... <u>6'</u> ...
Casing height above or <u>below</u> land surface... <u>26</u> ...in.	

6 GROUT PLUG MATERIAL: 1 Neat cement 2 Cement grout <input checked="" type="radio"/> 3 Bentonite 4 Other.....	
Grout Plug Intervals: From... <u>6</u> ...ft. to... <u>3</u> ...ft., From.....ft. to.....ft., From..... to.....ft.	
What is the nearest source of possible contamination:	
<input checked="" type="radio"/> 1 Septic tank 6 Seepage pit 11 Fuel storage 16 Other (specify below) 2 Sewer lines 7 Pit privy 12 Fertilizer storage 3 Watertight sewer lines 8 Sewage lagoon 13 Insecticide storage 4 Lateral lines 9 Feedyard 14 Abandoned water well 5 Cess Pool 10 Livestock pens 15 Oil well/Gas well	
Direction from well? ... <u>North</u>	How many feet? ... <u>2,640</u>

FROM	TO	PLUGGING MATERIALS
<u>42'</u>	<u>15'</u> 27	<u>Sand</u>
<u>15'</u> 27	<u>6'</u>	<u>Subsoil</u>
<u>6'</u>	<u>3'</u>	<u>Bentonite</u>
<u>3'</u>	<u>0'</u>	<u>Top Soil</u>

7 CONTRACTOR'S OR LANDOWNER'S CERTIFICATION:	This water well was plugged under my jurisdiction and was completed on (mo/day/year)...
	<u>1/18/99</u> and this record is true to the best of my knowledge and belief. Kansas Water Well Contractor's License No. This Water Well Record was completed on (mo/day/year) <u>1/22/99</u> under the business name of
	by (signature) <u>Doug Caldwell</u>

INSTRUCTIONS: Use typewriter or ball point pen. Please press firmly and print clearly. Please fill in blanks, underline or circle the correct answers. Send ~~up~~ three copies to Kansas Department of Health and Environment, Bureau of Water, Topeka, Kansas 66620-0001. Telephone: 913/296-3565. Send one to Water Well Owner and retain one for your records.