

WATER WELL RECORD Form WWC-5


Original Record Correction Change in Well Use

Division of Water Resources App. No.

Well ID

1 LOCATION OF WATER WELL: County: Dickinson Fraction 1/4 SW 1/4 NW 1/4 NE 1/4 Section Number 6 Township Number T 11 S Range Number R 3 E W

2 WELL OWNER: Last Name: Adams First: Jerry Street or Rural Address where well is located: 1350 1st Rd, Wakefield, Ks

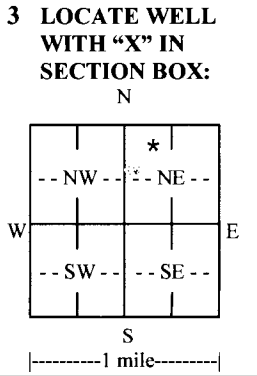

4 DEPTH OF COMPLETED WELL: 104 ft. Depth(s) Groundwater Encountered: 1) 39 ft. 2) 70 ft. WELL'S STATIC WATER LEVEL: 70 ft.

5 Latitude: Longitude: Datum: WGS 84 NAD 83 NAD 27 Source for Latitude/Longitude: GPS Land Survey Topographic Map Online Mapper

7 WELL WATER TO BE USED AS: 1. Domestic: [X] Household [] Lawn & Garden [] Livestock [] Irrigation [] Feedlot [] Industrial

Was a chemical/bacteriological sample submitted to KDHE? [] Yes [X] No If yes, date sample was submitted:

8 TYPE OF CASING USED: [] Steel [X] PVC [] Other CASING JOINTS: [X] Glued [] Clamped [] Welded [] Threaded

9 GROUT MATERIAL: [] Neat cement [] Cement grout [X] Bentonite [] Other

Nearest source of possible contamination: [X] Septic Tank [] Lateral Lines [] Pit Privy [] Livestock Pens [] Insecticide Storage

Table with columns: 10 FROM, TO, LITHOLOGIC LOG, FROM, TO, LITHO. LOG (cont.) or PLUGGING INTERVALS. Rows include BROWN CLAY, LITE COLOR CLAY & SHALE, LITE COLOR LIMESTONE, RED SHALE, GRAY SHALE, LITE COLOR LIMESTONE, GRAY SHALE, LITE COLOR LIMESTONE.

11 CONTRACTOR'S OR LANDOWNER'S CERTIFICATION: This water well was [X] constructed, [] reconstructed, or [] plugged under my jurisdiction and was completed on (mo-day-yr) 7/.12/.13