


Plugged

WATER WELL PLUGGING RECORD Form WWC-5P KSA 82a-1212 ID NO.

1 LOCATION OF WATER WELL: Fraction NW 1/4 NW 1/4 NE 1/4 Section Number 22 Township Number T 116S Range Number 3 E W

Street/Rural Address of Well Location; if unknown, distance & direction from nearest town or intersection: If at owner's address, check here
1678 3400 Ave Abilene, KS 67410
Global Positioning Systems (GPS) information:
Latitude: 39.0893886 (in decimal degrees)
Longitude: 97.0811317 (in decimal degrees)
Elevation: 1167'
Horizontal Datum: WGS84, NAD83, NAD27
Collection Method:

2 WATER WELL OWNER: Imogene Caughron
RR#, St. Address, Box #: 1678 3400 Ave.
City, State ZIP Code: Abilene, KS 67410
 GPS unit (Make/Model: Garmin E Tery 20)
 Digital Map/Photo, Topographic Map, Land Survey
Est. Accuracy: <3 m, 3-5 m, 5-15 m, >15 m

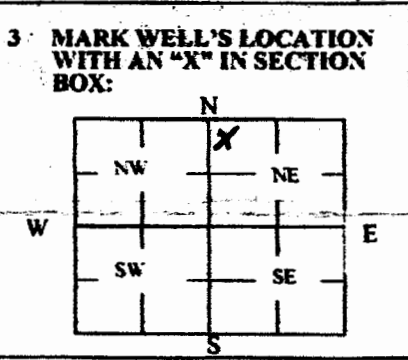

4 DEPTH OF WELL 62'
WELL'S STATIC WATER LEVEL 3' Above Ground, Flound out the Top
WELL WAS USED AS:
 Domestic Public Water Supply Dewatering
 Irrigation Oil Field Water Supply Monitoring
 Feedlot Domestic (Lawn & Garden) Injection Well
 Industrial Air Conditioning Other _____
Was a chemical/bacteriological sample submitted to Department? Yes No

5 TYPE OF BLANK CASING USED:
 Steel RMP (SR) Wrought Fiberglass Other (Specify below)
 PVC ABS Asbestos-Cement Concrete Tile
Blank casing diameter 6" in. Was casing pulled? Yes No If yes, how much _____
Casing height above or below land surface _____ in. Cut of 3' Below Ground

6 GROUT PLUG MATERIAL: Neat cement Cement grout Bentonite Other 1750 lbs Bagg
Grout Plug Intervals: From 3' ft. to 62' ft., From _____ ft. to _____ ft., From _____ ft. to _____ ft.
What is the nearest source of possible contamination: None Close
 Septic tank Seepage pit Fuel storage Other (specify below)
 Sewer lines Pit privy Fertilizer storage
 Watertight sewer lines Sewage lagoon Insecticide storage
 Lateral lines Feedyard Abandoned water well
 Cess pool Livestock pens Oil well/Gas well
Direction from well? _____
How many feet? _____

FROM	TO	PLUGGING MATERIALS	FROM	TO	PLUGGING MATERIALS
0	3'	Compacted Clay			
3	62'	Bentonite Grout			

7 CONTRACTOR'S OR LANDOWNER'S CERTIFICATION: This water well was plugged under my jurisdiction and was completed on (mo/day/year) 11/27/2020 and this record is true to the best of my knowledge and belief. Kansas Water Well Contractor's License No. 451. This Water Well Record was completed on (mo/day/year) 11/28/2020 under the business name of Halderson Well Drilling by (signature) Gary M. Gump