


4

1 LOCATION OF WATER WELL: Fraction SW 1/4 SW 1/4 SW 1/4 Section Number 15 Township Number T 11 S Range Number R 24 E
 County: Dickinson
 Distance and direction from nearest town or city street address of well if located within city?
2 1/8 miles East of Upland, Ks & 1/8 mile North

2 WATER WELL OWNER: Dale Smith
 RR#, St. Address, Box # : 1202 Crest Hill Dr. Board of Agriculture, Division of Water Resources
 City, State, ZIP Code : Junction City, Kansas 66441 Application Number:

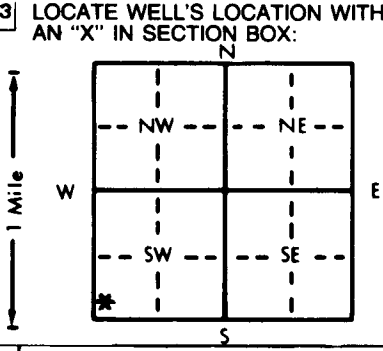

4 DEPTH OF COMPLETED WELL: 115 ft. ELEVATION: _____ ft.
 Depth(s) Groundwater Encountered 1. 84 ft. 2. _____ ft. 3. _____ ft.
 WELL'S STATIC WATER LEVEL 74 ft. below land surface measured on mo/day/yr 7 / 24 / 91
 Pump test data: Well water was _____ ft. after _____ hours pumping _____ gpm
 Est. Yield 20* gpm: Well water was _____ ft. after _____ hours pumping _____ gpm
 Bore Hole Diameter 9 in. to 115 ft., and _____ in. to _____ ft.
 WELL WATER TO BE USED AS: 5 Public water supply 8 Air conditioning 11 Injection well
 1 Domestic 3 Feedlot 6 Oil field water supply 9 Dewatering 12 Other (Specify below)
 2 Irrigation 4 Industrial 7 Lawn and garden only 10 Monitoring well _____
 Was a chemical/bacteriological sample submitted to Department? Yes _____ No *; If yes, mo/day/yr sample was submitted _____
 Water Well Disinfected? Yes * No

5 TYPE OF BLANK CASING USED: 5 Wrought iron 8 Concrete tile CASING JOINTS: Glued * Clamped _____
 1 Steel 3 RMP (SR) 6 Asbestos-Cement 9 Other (specify below) Welded _____
 2 PVC 4 ABS 7 Fiberglass Threaded _____
 Blank casing diameter 5 in. to 115 ft., Dia _____ in. to _____ ft., Dia _____ in. to _____ ft.
 Casing height above land surface 14 in., weight 160 lbs./ft. Wall thickness or gauge No. 214
 TYPE OF SCREEN OR PERFORATION MATERIAL: 7 PVC 10 Asbestos-cement
 1 Steel 3 Stainless steel 5 Fiberglass 8 RMP (SR) 11 Other (specify) _____
 2 Brass 4 Galvanized steel 6 Concrete tile 9 ABS 12 None used (open hole)
 SCREEN OR PERFORATION OPENINGS ARE: 5 Gauzed wrapped 8 Saw cut 11 None (open hole)
 1 Continuous slot 3 Mill slot 6 Wire wrapped 9 Drilled holes
 2 Louvered shutter 4 Key punched 7 Torch cut 10 Other (specify) _____
 SCREEN-PERFORATED INTERVALS: From 77 ft. to 115 ft., From _____ ft. to _____ ft.
 From _____ ft. to _____ ft., From _____ ft. to _____ ft.
 GRAVEL PACK INTERVALS: From 31 ft. to 115 ft., From _____ ft. to _____ ft.
 From _____ ft. to _____ ft., From _____ ft. to _____ ft.

6 GROUT MATERIAL: 1 Neat cement 2 Cement grout 3 Bentonite 4 Other _____
 Grout Intervals: From 3 ft. to 31 ft., From _____ ft. to _____ ft.
 What is the nearest source of possible contamination:
 1 Septic tank 4 Lateral lines 7 Pit privy 10 Livestock pens 14 Abandoned water well
 2 Sewer lines 5 Cess pool 8 Sewage lagoon 11 Fuel storage 15 Oil well/Gas well
 3 Watertight sewer lines 6 Seepage pit 9 Feedyard 12 Fertilizer storage 16 Other (specify below) _____
 13 Insecticide storage
 Direction from well? SOUTH & WEST How many feet? 75 will be

FROM	TO	LITHOLOGIC LOG	FROM	TO	PLUGGING INTERVALS
0	1	DARK TOP SOIL	110		
1	10	BROWN CLAY	110	115	GRAY SHALE
10	11	LITE COLOR CLAY			
11	25	LITE COLOR LIMESTONE			
25	34	LITE COLOR SHALEY CLAY			
34	39	LITE COLOR HARD LIMESTONE			
39	48	LITE COLOR SHALEY CLAY			
48	76	RED CLAY			
76	82	TAN & RED CLAY			
82	85	TAN CLAOE LIMESTONE			
85	90	GRAY LIMESTONE			
90	92	GRAY CLAY & SHALE			
92	96	HARD GRAY LIMESTONE			
96	105	GRAY CLAY			
105	110	LITE COLOR LIMESTONE			

7 CONTRACTOR'S OR LANDOWNER'S CERTIFICATION: This water well was (1) constructed, (2) reconstructed, or (3) plugged under my jurisdiction and was completed on (mo/day/year) 7 / 24 / 91 and this record is true to the best of my knowledge and belief. Kansas Water Well Contractor's License No. 397 This Water Well Record was completed on (mo/day/yr) 8 / 6 / 91 under the business name of CENTRAL KANSAS DRILLING by (signature) Harold J. Martin