


1 LOCATION OF WATER WELL: Fraction SW 1/4 SE 1/4 SW 1/4 Section Number 15 Township Number T 11 S Range Number R 24 E
 County: Dickinson

Distance and direction from nearest town or city street address of well if located within city?
2 1/2 miles East of Upland, Ks & 1/8 North

2 WATER WELL OWNER: Dave Whitley
 RR#, St. Address, Box # : Rt 3, Box 199 Board of Agriculture, Division of Water Resources
 City, State, ZIP Code : Junction City, Kansas 66441 Application Number:

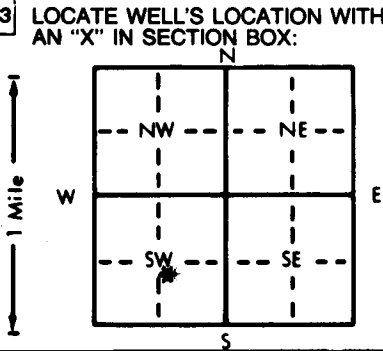

4 DEPTH OF COMPLETED WELL: 106 ft. ELEVATION:ft.
 Depth(s) Groundwater Encountered 1. 76 ft. 2.ft. 3.ft.
 WELL'S STATIC WATER LEVEL 72 ft. below land surface measured on mo/day/yr 4 / 4 / 89
 Pump test data: Well water wasft. after hours pumping gpm
 Est. Yield 10-12 gpm: Well water wasft. after hours pumping gpm
 Bore Hole Diameter 9 in. to 106 ft., andin. toft.
 WELL WATER TO BE USED AS: 5 Public water supply 8 Air conditioning 11 Injection well
 1 Domestic 3 Feedlot 6 Oil field water supply 9 Dewatering 12 Other (Specify below)
 2 Irrigation 4 Industrial 7 Lawn and garden only 10 Monitoring well
 Was a chemical/bacteriological sample submitted to Department? Yes.....No. *.....; If yes, mo/day/yr sample was sub-
 mitted Water Well Disinfected? Yes * No

5 TYPE OF BLANK CASING USED: 5 Wrought iron 8 Concrete tile CASING JOINTS: Glued * Clamped
 1 Steel 3 RMP (SR) 6 Asbestos-Cement 9 Other (specify below) Welded
 2 PVC 4 ABS 7 Fiberglass Threaded.....
 Blank casing diameter 5 in. to 106 ft., Diain. toft., Diain. toft.
 Casing height above land surface 15 in., weight 160 lbs./ft. Wall thickness or gauge No. 214
 TYPE OF SCREEN OR PERFORATION MATERIAL: 7 PVC 10 Asbestos-cement
 1 Steel 3 Stainless steel 5 Fiberglass 8 RMP (SR) 11 Other (specify)
 2 Brass 4 Galvanized steel 6 Concrete tile 9 ABS 12 None used (open hole)
 SCREEN OR PERFORATION OPENINGS ARE: 5 Gauzed wrapped 8 Saw cut 11 None (open hole)
 1 Continuous slot 3 Mill slot 6 Wire wrapped 9 Drilled holes
 2 Louvered shutter 4 Key punched 7 Torch cut 10 Other (specify)
 SCREEN-PERFORATED INTERVALS: From 70 ft. to 106 ft., Fromft. toft.
 Fromft. toft., Fromft. toft.
 GRAVEL PACK INTERVALS: From 24 ft. to 106 ft., Fromft. toft.
 Fromft. toft., Fromft. toft.

6 GROUT MATERIAL: 1 Neat cement 2 Cement grout 3 Bentonite 4 Other
 Grout Intervals: From 3 ft. to 24 ft., Fromft. toft., Fromft. toft.
 What is the nearest source of possible contamination: 10 Livestock pens 14 Abandoned water well
 1 Septic tank 4 Lateral lines 7 Pit privy 11 Fuel storage 15 Oil well/Gas well
 2 Sewer lines 5 Cess pool 8 Sewage lagoon 12 Fertilizer storage 16 Other (specify below)
 3 Watertight sewer lines 6 Seepage pit 9 Feedyard 13 Insecticide storage
 Direction from well? WEST How many feet? 59

FROM	TO	LITHOLOGIC LOG	FROM	TO	PLUGGING INTERVALS
0	6	BROWN CLAY			
6	14	LIMESTONE			
14	36	LITE COLOR SHALE			
36	38	LIMESTONE			
38	40	LITE COLOR SHALE			
40	71	RED SHALE			
71	75	HARD LIMESTONE			
75	79	SOFT LIMESTONE			
79	90	DARK SHALE			
90	99	GRAY SHALE			
99	103	LIMESTONE			
103	106	GRAY SHALE			

7 CONTRACTOR'S OR LANDOWNER'S CERTIFICATION: This water well was (1) constructed, (2) reconstructed, or (3) plugged under my jurisdiction and was completed on (mo/day/year) 4 / 4 / 89 and this record is true to the best of my knowledge and belief. Kansas Water Well Contractor's License No. 397 This Water Well Record was completed on (mo/day/yr) 5 / 17 / 89 under the business name CENTRAL KANSAS DRILLING by (signature) Harold D. Martin

1500000088-82