

CORRECTION TO WATER WELL RECORD (WWC-5)

The following correction(s) was made to the attached WWC-5 log, in order to file the item or to rectify lacking or incorrect information.

Fraction (1/4 1/4 1/4) Section-Township-Range changed:

listed as SE SW SW, 15-115-3-4E

changed to SE SW SW, 15-115-4E

Other changes: Initial statements: _____

Changed to: _____

Comments: _____

verification method: Written & legal descriptions, position on plat map,
and Upland & Milford Dam 1:24,000 topo maps. initials: DR date: 5/4/2001

submitted by: Kansas Geological Survey, Data Resources Library, 1930 Constant Ave., Lawrence, KS 66047-3726
to: Kansas Dept of Health & Environment Bureau of Water Industrial Programs, Bldg 283, Forbes Field, KS 66620


WATER WELL RECORD Form WWC-5 KSA 82a-1212

1 LOCATION OF WATER WELL:	Fraction	Section Number	Township Number	Range Number
County: <u>Dickinson</u>	<u>SE 1/4 SW 1/4 SW 1/4</u>	<u>15</u>	<u>T 11 S</u>	<u>R 3-4 EAW</u>

Distance and direction from nearest town or city street address of well if located within city?
2 1/8 miles East of Upland, Ks & 1/8 mile North

2 WATER WELL OWNER: Don Tanner
 RR#, St. Address, Box # : 2102 S. Estelle Board of Agriculture, Division of Water Resources
 City, State, ZIP Code : Wichita, Kansas 67211 Application Number:

3 LOCATE WELL'S LOCATION WITH AN "X" IN SECTION BOX:

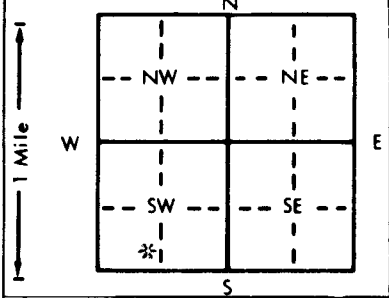

4 DEPTH OF COMPLETED WELL: 116 ft. ELEVATION:

Depth(s) Groundwater Encountered 1. 85 ft. 2. _____ ft. 3. _____ ft.
 WELL'S STATIC WATER LEVEL 80 ft. below land surface measured on mo/day/yr 3 / 27 / 92
 Pump test data: Well water was _____ ft. after _____ hours pumping _____ gpm
 Est. Yield 20+ gpm: Well water was _____ ft. after _____ hours pumping _____ gpm
 Bore Hole Diameter: 9 in. to 116 ft., and _____ in. to _____ ft.
 WELL WATER TO BE USED AS: 5 Public water supply 8 Air conditioning 11 Injection well
 1 Domestic 3 Feedlot 6 Oil field water supply 9 Dewatering 12 Other (Specify below)
 2 Irrigation 4 Industrial 7 Lawn and garden only 10 Monitoring well _____
 Was a chemical/bacteriological sample submitted to Department? Yes _____ No *; If yes, mo/day/yr sample was submitted
 Water Well Disinfected? Yes * No

5 TYPE OF BLANK CASING USED:

1 Steel	3 RMP (SR)	6 Asbestos-Cement	9 Other (specify below)	CASING JOINTS: Glued <u>*</u> Clamped _____
2 PVC	4 ABS	7 Fiberglass		Welded _____
				Threaded _____

Blank casing diameter 5 in. to 116 ft., Dia _____ in. to _____ ft., Dia _____ in. to _____ ft.
 Casing height above land surface 14 in., weight 160 lbs./ft. Wall thickness or gauge No. 214

TYPE OF SCREEN OR PERFORATION MATERIAL:

1 Steel	3 Stainless steel	5 Fiberglass	8 RMP (SR)	10 Asbestos-cement
2 Brass	4 Galvanized steel	6 Concrete tile	9 ABS	11 Other (specify) _____
				12 None used (open hole)

SCREEN OR PERFORATION OPENINGS ARE:

1 Continuous slot	3 Mill slot	5 Gauzed wrapped	8 Saw cut	11 None (open hole)
2 Louvered shutter	4 Key punched	6 Wire wrapped	9 Drilled holes	
		7 Torch cut	10 Other (specify) _____	

SCREEN-PERFORATED INTERVALS: From 83 ft. to 116 ft., From _____ ft. to _____ ft.
 From _____ ft. to _____ ft., From _____ ft. to _____ ft.
GRAVEL PACK INTERVALS: From 29 ft. to 116 ft., From _____ ft. to _____ ft.
 From _____ ft. to _____ ft., From _____ ft. to _____ ft.

6 GROUT MATERIAL: 1 Neat cement 2 Cement grout 3 Bentonite 4 Other _____
 Grout intervals: From 3 ft. to 29 ft., From _____ ft. to _____ ft., From _____ ft. to _____ ft.

What is the nearest source of possible contamination:

1 Septic tank	4 Lateral lines	7 Pit privy	10 Livestock pens	14 Abandoned water well
2 Sewer lines	5 Cess pool	8 Sewage lagoon	11 Fuel storage	15 Oil well/Gas well
3 Watertight sewer lines	6 Seepage pit	9 Feedyard	12 Fertilizer storage	16 Other (specify below)
			13 Insecticide storage	

Direction from well? SOUTHWEST How many feet? 100

FROM	TO	LITHOLOGIC LOG	FROM	TO	PLUGGING INTERVALS
0	1	DARK TOP SOIL	110	116	GRAY CLAY & SHALE
1	9	BROWN CLAY			
9	24	LITE COLOR LIMESTONE			
24	37	LITE COLOR CLAY & SHALE			
37	40	LITE COLOR LIMESTONE			
40	48	LITE COLOR SHALE & CLAY			
48	73	RED CLAY & SHALE			
73	75	TAN & RED CLAY			
75	77	LITE COLOR SHALEY CLAY			
77	82	RED CLAY			
82	90	TAN LIMESTONE			
90	92	GRAY SHALE			
92	96	HARD GRAY LIMESTONE			
96	107	GRAY CLAY			
107	110	LITE COLOR LIMESTONE			

7 CONTRACTOR'S OR LANDOWNER'S CERTIFICATION: This water well was (1) constructed, (2) reconstructed, or (3) plugged under my jurisdiction and was completed on (mo/day/year) 3 / 27 / 92 and this record is true to the best of my knowledge and belief. Kansas Water Well Contractor's License No. 397 This Water Well Record was completed on (mo/day/yr) 3 / 30 / 92 under the business name of CENTRAL KANSAS DRILLING by (signature) Harold D. Martin

INSTRUCTIONS: Use typewriter or ball point pen. PLEASE PRESS FIRMLY and PRINT clearly. Please fill in blanks, underline or circle the correct answers. Send top three copies to Kansas Department of Health and Environment, Bureau of Water, Topeka, Kansas 66620-0001. Telephone: 913-296-5545. Send one to WATER WELL OWNER and retain one for your records.