


1 LOCATION OF WATER WELL: Fraction SW 1/4 SW 1/4 NW 1/4 Section Number 36 Township Number T 11 S Range Number R 1 E

Distance and direction from nearest town or city street address of well if located within city?
5 miles West of Junction City, Ks on Hwy 18 & 1 1/2 miles North on East side of road

2 WATER WELL OWNER: Harvey Gfeller
 RR#, St. Address, Box #: Rt 3, Box 274 Board of Agriculture, Division of Water Resources
 City, State, ZIP Code: Junction City, Kansas 66111 Application Number:

3 LOCATE WELL'S LOCATION WITH AN "X" IN SECTION BOX:

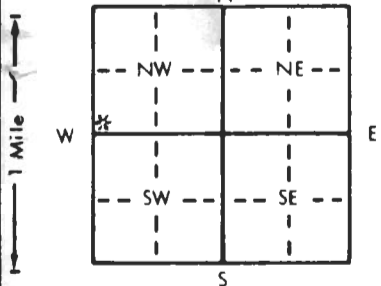

4 DEPTH OF COMPLETED WELL: 123 ft. ELEVATION:ft.
 Depth(s) Groundwater Encountered 1. 98 ft. 2.ft. 3.ft.
 WELL'S STATIC WATER LEVEL 91 ft. below land surface measured on mo/day/yr 1 / 17 / 90
 Pump test data: Well water wasft. after hours pumping gpm
 Est. Yield 15+ gpm: Well water wasft. after hours pumping gpm
 Bore Hole Diameter 9 in. to 123 ft., and in. to ft.
 WELL WATER TO BE USED AS: 5 Public water supply 8 Air conditioning 11 Injection well
1 Domestic 3 Feedlot 6 Oil field water supply 9 Dewatering 12 Other (Specify below)
2 Irrigation 4 Industrial 7 Lawn and garden only 10 Monitoring well
 Was a chemical/bacteriological sample submitted to Department? Yes.....No *; If yes, mo/day/yr sample was submitted
 Water Well Disinfected? Yes * No

5 TYPE OF BLANK CASING USED:
 1 Steel 3 RMP (SR) 5 Wrought iron 8 Concrete tile CASING JOINTS: Glued * Clamped
2 PVC 4 ABS 6 Asbestos-Cement 9 Other (specify below) Welded
 7 Fiberglass Threaded

Blank casing diameter 5 in. to 123 ft., Dia in. to ft., Dia in. to ft.
 Casing height above land surface 14 in., weight 200 lbs./ft. Wall thickness or gauge No.

TYPE OF SCREEN OR PERFORATION MATERIAL:
 1 Steel 3 Stainless steel 5 Fiberglass 7 PVC 10 Asbestos-cement
 2 Brass 4 Galvanized steel 6 Concrete tile 8 RMP (SR) 11 Other (specify)
 9 ABS 12 None used (open hole)

SCREEN OR PERFORATION OPENINGS ARE:
 1 Continuous slot 3 Mill slot 5 Gauzed wrapped 8 Saw cut 11 None (open hole)
 2 Louvered shutter 4 Key punched 6 Wire wrapped 9 Drilled holes
 7 Torch cut 10 Other (specify)

SCREEN-PERFORATED INTERVALS: From 93 ft. to 123 ft., From ft. to ft.
 From ft. to ft., From ft. to ft.
 GRAVEL PACK INTERVALS: From 27 ft. to 123 ft., From ft. to ft.
 From ft. to ft., From ft. to ft.

6 GROUT MATERIAL: 1 Neat cement 2 Cement grout 3 Bentonite 4 Other
 Grout Intervals: From 4 ft. to 27 ft., From ft. to ft., From ft. to ft.

What is the nearest source of possible contamination:
 1 Septic tank 4 Lateral lines 7 Pit privy 10 Livestock pens 14 Abandoned water well
 2 Sewer lines 5 Cess pool 8 Sewage lagoon 11 Fuel storage 15 Oil well/Gas well
 3 Watertight sewer lines 6 Seepage pit 9 Feedyard 12 Fertilizer storage 16 Other (specify below)
 13 Insecticide storage

Direction from well? NORTHWEST How many feet? 75

FROM	TO	LITHOLOGIC LOG	FROM	TO	PLUGGING INTERVALS
0	1	DARK TOP SOIL			
1	7	LITE BROWN CLAY			
7	21	LIMESTONE & SHALE			
21	47	LITE COLOR SHALE			
47	71	RED CLAY & SHALE			
71	75	LITE COLOR SHALE			
75	80	LITE COLOR LIMESTONE			
80	85	DARK LIMESTONE			
85	89	BROWN & TAN LIMESTONE			
89	91	LITE COLOR SHALE			
91	94	LITE GRAY SHALE			
94	96	LITE COLOR SHALE			
96	108	LITE LIMESTONE			
108	123	GRAY HARD LIMESTONE			

7 CONTRACTOR'S OR LANDOWNER'S CERTIFICATION: This water well was (1) constructed, (2) reconstructed, or (3) plugged under my jurisdiction and was completed on (mo/day/year) 1 / 17 / 90 and this record is true to the best of my knowledge and belief. Kansas
 Water Well Contractor's License No. 397 This Water Well Record was completed on (mo/day/yr) 3 / 5 / 90
 under the business name of CENTRAL KANSAS DRILLING by (signature) Arnold D. Martin