


1 LOCATION OF WATER WELL: County: DICKINSON Fraction: NW 1/4 NW 1/4 SE 1/4 Section Number: 3 Township Number: T 11 S Range Number: R 4 E
 Distance and direction from nearest town or city street address of well if located within city? From S.C. Go 11 miles north west on 244 Union Rd. to 3600 Rd. then go north 1/2 mile & west 1/2 mile

2 WATER WELL OWNER: Richard EYSTONE
 RR#, St. Address, Box #: 841 Wildcat Ridge Board of Agriculture, Division of Water Resources
 City, State, ZIP Code: Marion, KS 66502 Application Number:

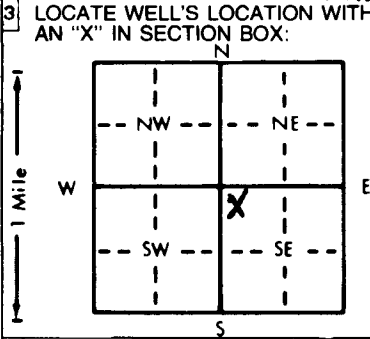

4 DEPTH OF COMPLETED WELL: 123 ft. ELEVATION: 160 ft.
 Depth(s) Groundwater Encountered: 1. 123 ft. 2. _____ ft. 3. _____ ft.
 WELL'S STATIC WATER LEVEL: 110 ft. below land surface measured on mo/day/yr
 Pump test data: Well water was _____ ft. after _____ hours pumping _____ gpm
 Est. Yield: 200 gpm Well water was _____ ft. after _____ hours pumping _____ gpm
 Bore Hole Diameter: 9 in. to 160 ft. and _____ in. to _____ ft.
 WELL WATER TO BE USED AS:
 1 Domestic 2 Irrigation 3 Feedlot 4 Industrial 5 Public water supply 6 Oil field water supply 7 Lawn and garden only 8 Air conditioning 9 Dewatering 10 Monitoring well 11 Injection well 12 Other (Specify below)
 Was a chemical/bacteriological sample submitted to Department? Yes _____ No _____ If yes, mo/day/yr sample was submitted _____
 Water Well Disinfected? Yes No

5 TYPE OF BLANK CASING USED:
 1 Steel 2 PVC 3 RMP (SR) 4 ABS 5 Wrought iron 6 Asbestos-Cement 7 Fiberglass 8 Concrete tile 9 Other (specify below)
 Blank casing diameter: 5 in. to 140 ft. Dia. _____ in. to _____ ft. Dia. _____ in. to _____ ft.
 Casing height above land surface: 2 in. weight 5640 lbs./ft. Wall thickness or gauge No. _____
 TYPE OF SCREEN OR PERFORATION MATERIAL:
 1 Steel 2 Brass 3 Stainless steel 4 Galvanized steel 5 Fiberglass 6 Concrete tile 7 PVC 8 RMP (SR) 9 ABS 10 Asbestos-cement 11 Other (specify) _____ 12 None used (open hole)
 SCREEN OR PERFORATION OPENINGS ARE:
 1 Continuous slot 2 Mill slot 3/1000 3 Gauzed wrapped 4 Wire wrapped 5 Saw cut 6 None (open hole)
 2 Louvered shutter 4 Key punched 7 Torch cut 10 Other (specify) _____
 SCREEN-PERFORATED INTERVALS: From 140 ft. to 160 ft. From _____ ft. to _____ ft.
 GRAVEL PACK INTERVALS: From 25 ft. to 160 ft. From _____ ft. to _____ ft.

6 GROUT MATERIAL: 1 Neat cement 2 Cement grout 3 Bentonite 4 Other _____
 Grout Intervals: From 0 ft. to 25 ft. From _____ ft. to _____ ft. From _____ ft. to _____ ft.
 What is the nearest source of possible contamination: None Close
 1 Septic tank 2 Sewer lines 3 Watertight sewer lines 4 Lateral lines 5 Cess pool 6 Seepage pit 7 Pit privy 8 Sewage lagoon 9 Feedyard 10 Livestock pens 11 Fuel storage 12 Fertilizer storage 13 Insecticide storage 14 Abandoned water well 15 Oil well/Gas well 16 Other (specify below) _____

Direction from well? _____ How many feet? _____

FROM	TO	LITHOLOGIC LOG	FROM	TO	PLUGGING INTERVALS
0	1	Top Soil			
1	11	Brown Clay			
11	14	Limstone			
14	37	Capimish Shale			
37	41	Limstone P			
41	55	Brown Shale			
55	70	Limstone			
70	76	Brown Shale			
76	80	Limstone			
80	95	Yellow Shale			
95	101	Limstone			
101	123	Brown Shale			
123	146	Limstone (Water)			
146	160	Grey Shale			

7 CONTRACTOR'S OR LANDOWNER'S CERTIFICATION: This water well was (1) constructed, (2) reconstructed, or (3) plugged under my jurisdiction and was completed on (mo/day/year) 12/12/98 and this record is true to the best of my knowledge and belief. Kansas Water Well Contractor's License No. 451 This Water Well Record was completed on (mo/day/yr) 12/18/98 under the business name of Haldeman Well Drilling by (signature) Wayne E. Ewing

OFFICE USE ONLY T R E W SEC 1/4 1/4 1/4