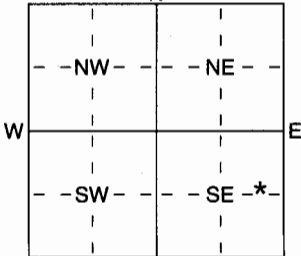


1	LOCATION OF WATER WELL: County: <u>Geary</u>	Fraction <u>SE 1/4 NE 1/4 SE 1/4</u>	Section Number <u>36</u>	Township Number <u>T 11 S</u>	Range Number <u>R 4-5 E/W*</u>
---	---	---	-----------------------------	----------------------------------	-----------------------------------

Distance and direction from nearest town or city street address of well if located within city?
4 miles West of Junction City on Hwy 18 to Crider Rd * go 1 3/8 miles North to

2	WATER WELL OWNER: <u>Charles W. Gfeller</u> RR#, St. Address, Box # : <u>3526 N Crider Rd</u> City, State, ZIP Code : <u>Junction City, Kansas 66441</u>	<u>3526 N. Crider Rd</u> Board of Agriculture, Division of Water Resources Application Number:
---	--	--

3	LOCATE WELL'S LOCATION WITH AN "X" IN SECTION BOX: 	4 DEPTH OF COMPLETED WELL <u>12.1</u> ft. ELEVATION:
Depth(s) Groundwater Encountered 1 <u>8.7</u> ft. 2 ft. 3 ft. WELL'S STATIC WATER LEVEL <u>8.2</u> ft. below land surface measured on mo/day/yr <u>1.1</u> / <u>1.9</u> / <u>0.4</u> Pump test data: Well water was ft. after hours pumping gpm Est. Yield <u>1.2</u> gpm: Well water was ft. after hours pumping gpm WELL WATER TO BE USED AS: 5 Public water supply 8 Air conditioning 11 Injection well 1 Domestic 3 Feedlot 6 Oil field water supply 9 Dewatering 12 Other (Specify below) 2 Irrigation 4 Industrial 7 Domestic (lawn & garden) 10 Monitoring well		
Was a chemical/bacteriological sample submitted to Department? Yes No * ; If yes, mo/day/yr sample was submitted		Water Well Disinfected? Yes * No

5	TYPE OF BLANK CASING USED: 1 Steel 3 RMP (SR) 2 PVC 4 ABS	5 Wrought iron 6 Asbestos-Cement 7 Fiberglass	8 Concrete tile 9 Other (specify below)	CASING JOINTS: Glued * Clamped Welded Threaded
Blank casing diameter <u>5</u> in. to <u>12.1</u> ft., Dia in. to ft., Dia in. to ft.				
Casing height above land surface <u>1.6</u> in., weight <u>2.0.0</u> lbs./ft. Wall thickness or gauge No. <u>2.5.0</u>				
TYPE OF SCREEN OR PERFORATION MATERIAL: 1 Steel 3 Stainless Steel 5 Fiberglass 7 PVC 10 Asbestos-Cement 2 Brass 4 Galvanized Steel 6 Concrete tile 8 RMP (SR) 11 Other (Specify) 12 None used (open hole)				
SCREEN OR PERFORATION OPENINGS ARE: 1 Continuous slot 3 Mill slot 5 Gauzed wrapped 8 Saw cut 11 None (open hole) 2 Louvered shutter 4 Key punched 6 Wire wrapped 9 Drilled holes 7 Torch cut 10 Other (specify)				
SCREEN-PERFORATED INTERVALS: From <u>8.1</u> ft. to <u>12.1</u> ft., From ft. to ft. From ft. to ft., From ft. to ft.				
GRAVEL PACK INTERVALS: From <u>2.5</u> ft. to <u>12.1</u> ft., From ft. to ft. From ft. to ft., From ft. to ft.				

6	GROUT MATERIAL: 1 Neat cement 2 Cement grout 3 Bentonite 4 Other
Grout Intervals: From <u>2</u> ft. to <u>2.5</u> ft., From ft. to ft., From ft. to ft.	
What is the nearest source of possible contamination: 1 Septic tank 4 Lateral lines 7 Pit privy 10 Livestock pens 14 Abandoned water well 2 Sewer lines 5 Cess pool 8 Sewage lagoon 11 Fuel storage 15 Oil well/Gas well 3 Watertight sewer lines 6 Seepage pit 9 Feedyard 12 Fertilizer storage 16 Other (specify below) 13 Insecticide storage	
Direction from well? <u>EAST</u> APPROX How many feet? <u>150+</u>	

FROM	TO	LITHOLOGIC LOG	FROM	TO	*PLUGGING INTERVALS*
0	1	DARK TOP SOIL	84	86	LITE COLOR SHALE
1	9	BROWN CLAY	86	89	LITE COLOR LIMESTONE
9	10	LITE COLOR SHALE	89	107	GRAY LIMESTONE
10	12	LITE COLOR LIMESTONE	107	112	GRAY SHALE
12	18	LITE COLOR CLAY & SHALE	112	117	GRAY LIMESTONE
18	20	LIMESTONE	117	121	LITE GRAY LIMESTONE
20	26	LITE COLOR CLAY & SHALE			
26	48	RED SHALE & CLAY			
28	56	LITE COLOR SHALE & CLAY			
56	67	LITE COLOR LIMESTONE			
67	73	GRAY SHALE			
73	76	LITE COLOR LIMESTONE			
76	81	LITE COLOR SHALE			
81	84	GRAY SHALE			

RECEIVED
NOV 30 2004
BUREAU OF WATER

7	CONTRACTOR'S OR LANDOWNER'S CERTIFICATION: This water well was (1) constructed, (2) reconstructed, or (3) plugged under my jurisdiction and was completed on (mo/day/year) <u>1.1</u> / <u>1.9</u> / <u>0.4</u> and this record is true to the best of my knowledge and belief. Kansas Water Well Contractor's Licence No <u>3.9.7</u> This Water Well Record was completed on (mo/day/yr) <u>1.1</u> / <u>2.9</u> / <u>0.4</u> under the business name of <u>CENTRAL KANSAS DRILLING</u> by (signature) <u>Harold D. Masten</u>
---	--

INSTRUCTIONS: Use typewriter or ball point pen. PLEASE PRESS FIRMLY and PRINT clearly. Please fill in blanks, underline or circle the correct answers. Send top three copies to Kansas Department of Health and Environment, Bureau of Water, Geology Section, 1000 SW Jackson St., Suite 420, Topeka, Kansas 66612-1367. Telephone 785-296-5522. Send one to WATER WELL OWNER and retain one for your records. Fee of \$5.00 for each constructed well.