

County: Dickinson Fraction NE SE SE SE Sec. 22 T 11 S R 4 (E/W)

CORRECTION(S) TO WATER WELL COMPLETION RECORD (WWC-5)
(to rectify lacking or incorrect information)

Owner: Dennis Shumate

Location was listed as:

Section-Township-Range: 5-22S-4E

Fraction (1/4 1/4 1/4): SW SE SE

Location changed to:

22-11S-4E

NE SE SE SE

Other changes: Initial statements: Owner: Dennis Schumate

Changed to: Dennis Shumate

Comments: online directory gives owner's current address as 3332 Union Rd., Junction City, KS 66441.

Verification method: Written description, county ownership directory, owner's address & area road map, and mapping tool & aerial photos on KGS website.

Submitted by: Kansas Geological Survey, Data Resources Library, 1930 Constant Ave., Lawrence, KS 66047-3726 initials: ARL date: 10/3/2012
to: Kansas Dept of Health & Environment, Bureau of Water, 1000 SW Jackson, Suite 420, Topeka, KS 66612-1367.

9000


WATER WELL RECORD Form WWC-5 KSA 82a-1212

1] LOCATION OF WATER WELL: County: Dickinson Fraction: SW 1/4 SE 1/4 SE 1/4 Section Number: 5 Township Number: T 22 S Range Number: R 4 E

Distance and direction from nearest town or city street address of well if located within city? on Republican river bridge south to 2 ft 4 ft highway west 5 miles 1 mi north

2] WATER WELL OWNER: Dennis Schumate Board of Agriculture, Division of Water Resources Application Number: 330 West - 15th St Junction City KS 66441

3] LOCATE WELL'S LOCATION WITH AN "X" IN SECTION BOX:

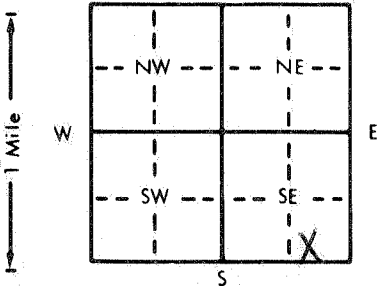

4] DEPTH OF COMPLETED WELL: 9.7 ft. ELEVATION: 75 to 90 ft. 2. 70 ft. 3. 97 ft.

WELL'S STATIC WATER LEVEL: 70 ft. below land surface measured on mo/day/yr 3-20-1985. Pump test data: Well water was 2.0 gpm; Well water was 1.0 in. to 1.5 ft. after 6 1/2 hours pumping 97 gpm.

WELL WATER TO BE USED AS: 1 Domestic, 3 Feedlot, 6 Oil field water supply, 8 Air conditioning, 11 Injection well, 2 Irrigation, 4 Industrial, 7 Lawn and garden only, 9 Dewatering, 12 Other (Specify below). Was a chemical/bacteriological sample submitted to Department? Yes X No X. If yes, mo/day/yr sample was submitted X Water Well Disinfected? Yes X No X

5] TYPE OF BLANK CASING USED: 2 PVC, 3 RMP (SR), 6 Asbestos-Cement, 9 Other (specify below). CASING JOINTS: X Glued, X Clamped, X Welded, X Threaded.

Blank casing diameter: 5 in. to 5 1/2 in. Dia. 5 in. to 9 7/8 in. Dia. Casing height above land surface: 12 in., weight 1.65 lbs./ft. Wall thickness or gauge No. 200 P.S.I.

TYPE OF SCREEN OR PERFORATION MATERIAL: 1 Steel, 3 Stainless steel, 5 Fiberglass, 8 RMP (SR), 10 Asbestos-cement, 2 Brass, 4 Galvanized steel, 6 Concrete tile, 9 ABS, 11 Other (specify), 12 None used (open hole).

SCREEN OR PERFORATION OPENINGS ARE: 1 Continuous slot, 3 Mill slot, 5 Gauzed wrapped, 8 Saw cut, 11 None (open hole), 2 Louvered shutter, 4 Key punched, 6 Wire wrapped, 9 Drilled holes, 7 Torch cut, 10 Other (specify).

SCREEN-PERFORATED INTERVALS: From 9.7 ft. to 9.7 ft. GRAVEL PACK INTERVALS: From 9.7 ft. to 1.5 ft.

6] GROUT MATERIAL: 1 Neat cement, 2 Cement grout, 3 Bentonite, 4 Other. Grout Intervals: From 1.5 ft. to 4 ft.

What is the nearest source of possible contamination: 10 Livestock pens, 14 Abandoned water well, 11 Fuel storage, 15 Oil well/Gas well, 12 Fertilizer storage, 16 Other (specify below) Small Creek, 13 Insecticide storage, 9 Feedyard, 3 Watertight sewer lines, 6 Seepage pit, 4 Lateral lines, 8 Sewage lagoon, 2 Sewer lines, 5 Cess pool, 7 Pit privy.

Direction from well? north How many feet? 200

| FROM | TO | LITHOLOGIC LOG | FROM | TO | LITHOLOGIC LOG |
|------|----|----------------------|------|-------|----------------|
| 0 | 1 | top soil | | | |
| 1 | 28 | lime rock | | | |
| 28 | 40 | clay, red | | | |
| 40 | 68 | shale yellow | | | |
| 68 | 75 | Rock Limestone water | 75 | 90 ft | |
| 75 | 97 | Shale, Blue | | | |

for a new house

7] CONTRACTOR'S OR LANDOWNER'S CERTIFICATION: This water well was (1) constructed, (2) reconstructed, or (3) plugged under my jurisdiction and was completed on (mo/day/year) 3-20-1985 and this record is true to the best of my knowledge and belief. Kansas Water Well Contractor's License No. 237 This Water Well Record was completed on (mo/day/yr) 3-22-1985 under the business name of Strader Drilling Co by (signature) Harold Strader

INSTRUCTIONS: Use typewriter or ball point pen, PLEASE PRESS FIRMLY and PRINT clearly. Please fill in blanks, underline or circle the correct answers. Send to three copies to Kansas Department of Health and Environment, Division of Environment, Environmental Geology Section, Topeka, KS 66620. Send one to WATER WELL OWNER and retain one for your records.