

## CORRECTION(S) TO WATER WELL RECORD (WWC-5)

(to rectify lacking or incorrect information)

County: Dickinson

Location listed as:

Location changed to:

Section-Township-Range: None Given31-115-4EFraction (  $\frac{1}{4}$   $\frac{1}{4}$   $\frac{1}{4}$ ): NW NE NENW NE NE

Other changes: Initial statements:

Changed to:

Comments:

verification method: Written & legal descriptions, position on plat map,  
and Junction City, Milford Dam, & Upland 1:24,000 topo. maps.

initials: DRJ date: 7/11/2005


submitted by: Kansas Geological Survey, Data Resources Library, 1930 Constant Ave., Lawrence, KS 66047-3726  
 to: Kansas Dept of Health & Environment, Bureau of Water, 1000 SW Jackson, Suite 420, Topeka, KS 66612-1367.

1 LOCATION OF WATER WELL: Fraction NW 1/4 NE 1/4 NE 1/4 Section Number Township Number T S Range Number R E/W

Distance and direction from nearest town or city street address of well if located within city? 5775 24460 8 miles west From Junction City Ga Pass

2 WATER WELL OWNER: Diane Hancock RR#, St. Address, Box #: P.O. Box 1245 City, State, ZIP Code: Junction City, KS 66441 Board of Agriculture, Division of Water Resources Application Number:

3 LOCATE WELL'S LOCATION WITH AN "X" IN SECTION BOX: 4 DEPTH OF COMPLETED WELL: 110 ft. ELEVATION:

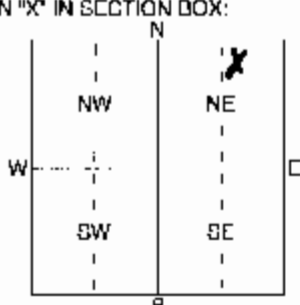

Depth(s) Groundwater Encountered: 1 ft. 2 ft. 3 ft. WELL'S STATIC WATER LEVEL: 20 ft. below land surface measured on mo/day/yr Pump test data: Well water was ... ft. after ... hours pumping ... Est. Yield: 30.7 gpm: Well water was ... ft. after ... hours pumping ... WELL WATER TO BE USED AS: 5 Public water supply 8 Air conditioning 11 Injection well 6 Oil field water supply 9 Dewatering 12 Other (Specify below) 1 Domestic 3 Feedlot 7 Domestic (lawn & garden) 10 Monitoring well 2 Irrigation 4 Industrial

Was a chemical/bacteriological sample submitted to Department? Yes No If yes, mo/day/yr sample was submitted Water Well Disinfected? Yes No

5 TYPE OF BLANK CASING USED: 1 Steel 3 RMP (SR) 5 Wrought iron 8 Concrete tile CASING JOINTS: 6 Glued 7 Clamped 2 PVC 4 ABS 7 Fiberglass 9 Other (specify below) 10 Threaded

Blank casing diameter: 5 1/2 in. to 90 ft. Dia. Casing height above land surface: 2 in. weight: 30.40 lbs./ft. Wall thickness or gauge No.

TYPE OF SCREEN OR PERFORATION MATERIAL: 1 Steel 3 Stainless Steel 5 Fiberglass 8 RMP (SR) 10 Asbestos-Cement 2 Brass 4 Galvanized Steel 6 Concrete tile 9 ABS 11 Other (Specify) 12 None used (open hole)

SCREEN OR PERFORATION OPENINGS ARE: 1 Continuous slot 3 Mill slot 25 / 1000 5 Gauzed wraprod 8 Saw cut 11 None (open hole) 2 Louvered shutter 4 Key punched 6 Wire wrapped 9 Drilled holes 10 Other (specify) 7 Tooth cut

SCREEN-PERFORATED INTERVALS: From 90 ft. to 110 ft. GRAVEL PACK INTERVALS: From 2.5 ft. to 110 ft.

6 GROUT MATERIAL: 1 Neat cement 2 Cement grout 3 Bentonite 4 Other Grout intervals: From 5 ft. to 25 ft.

What is the nearest source of possible contamination? 1 Septic tank 4 Lateral lines 7 Pit privy 10 Livestock pens 14 Abandoned water well 2 Sewer lines 5 Cess pool 8 Sewage lagoon 11 Fuel storage 15 Oil well/Gas well 3 Watertight sewer lines 6 Seepage pit 9 Feedyard 12 Fertilizer storage 16 Other (specify below) 13 Insecticide storage Direction from well? How many feet?

Table with columns: FROM, TO, LITHOLOGIC LOG, FROM, TO, PLUGGING INTERVALS. Rows include: 0-1 Top Soil, 1-12 Shales, 12-14 limestone, 14-31 yellow shale, 31-33 limestone, 33-64 Brown shale, 64-92 limestone, 92-94 Gray silty shale, 94-110 limestone.

RECEIVED OCT 26 2004 BUREAU OF WATER

7 CONTRACTOR'S OR LANDOWNER'S CERTIFICATION: This water well was (1) constructed, (2) reconstructed, or (3) plugged under my jurisdiction and was completed on (mo/day/year) 9/22/2004 and this record is true to the best of my knowledge and belief. Kansas Water Well Contractor's Licence No. 65 This Water Well Record was completed on (mo/day/year) 10/22/2004 under the business name of Holdreem Well Drilling by (signature) Leah M. Coyle