WATER WELL RECORD Form WWC-5 KSA 82a-1212 ID No.

1 LOCATION OF WATER WELL:	Fraction	Section Number	Township Number	Range Number
County: Dickinson	SW ¼ SE ¼ SE ¼	20	T 11 S	R 4 E/W*

Distance and direction from nearest town or city street address of well if located within city?
7 miles North of Chapman, Ks to 3300 Ave & East 3/4 mile

2 WATER WELL OWNER: Steve Gfeller
RR#, St. Address, Box # : 2077 - 3300 Ave
City, State, ZIP Code : Chapman, Kansas 67431
Board of Agriculture, Division of Water Resources Application Number:

3 LOCATE WELL'S LOCATION WITH AN "X" IN SECTION BOX:

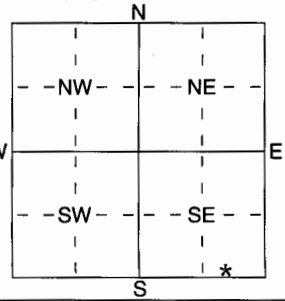

4 DEPTH OF COMPLETED WELL 162 ft. ELEVATION:
Depth(s) Groundwater Encountered 1 108 ft. 2 ft. 3 ft.
WELL'S STATIC WATER LEVEL 102 ft. below land surface measured on mo/day/yr 7 / 11 / 05
Pump test data: Well water was ft. after hours pumping gpm
Est. Yield 15+ gpm: Well water was ft. after hours pumping gpm
WELL WATER TO BE USED AS: 1 Domestic 2 Irrigation 3 Feedlot 4 Industrial 5 Public water supply 6 Oil field water supply 7 Domestic (lawn & garden) 8 Air conditioning 9 Dewatering 10 Monitoring well 11 Injection well 12 Other (Specify below)

Was a chemical/bacteriological sample submitted to Department? Yes No *; If yes, mo/day/yrs sample was submitted
Water Well Disinfected? Yes * No

5 TYPE OF BLANK CASING USED: 1 Steel 2 PVC 3 RMP (SR) 4 ABS 5 Wrought iron 6 Asbestos-Cement 7 Fiberglass 8 Concrete tile 9 Other (specify below)
CASING JOINTS: Glued * Clamped Welded Threaded

Blank casing diameter 5 in. to 162 ft., Dia in. to ft., Dia in. to ft.
Casing height above land surface 15 in., weight 200 lbs./ft. Wall thickness or guage No. .250

TYPE OF SCREEN OR PERFORATION MATERIAL: 1 Steel 2 Brass 3 Stainless Steel 4 Galvanized Steel 5 Fiberglass 6 Concrete tile 7 PVC 8 RMP (SR) 9 ABS 10 Asbestos-Cement 11 Other (Specify) 12 None used (open hole)

SCREEN OR PERFORATION OPENINGS ARE: 1 Continuous slot 2 Louvered shutter 3 Mill slot 4 Key punched 5 Guazed wrapped 6 Wire wrapped 7 Torch cut 8 Saw cut 9 Drilled holes 10 Other (specify) 11 None (open hole)

SCREEN-PERFORATED INTERVALS: From 102 ft. to 162 ft., From ft. to ft.
From ft. to ft., From ft. to ft.
GRAVEL PACK INTERVALS: From 26 ft. to 162 ft., From ft. to ft.
From ft. to ft., From ft. to ft.

6 GROUT MATERIAL: 1 Neat cement 2 Cement grout 3 Bentonite 4 Other
Grout Intervals: From 3 ft. to 26 ft., From ft. to ft., From ft. to ft.

What is the nearest source of possible contamination: 1 Septic tank 2 Sewer lines 3 Watertight sewer lines 4 Lateral lines 5 Cess pool 6 Seepage pit 7 Pit privy 8 Sewage lagoon 9 Feedyard 10 Livestock pens 11 Fuel storage 12 Fertilizer storage 13 Insecticide storage 14 Abandoned water well 15 Oil well/Gas well 16 Other (specify below)
Direction from well? WEST APPROX How many feet? 85

FROM	TO	LITHOLOGIC LOG	FROM	TO	*PLUGGING INTERVALS
0	1	DARK TOP SOIL	99	102	GRAY CLAY & SHALE
1	8	BROWN CLAY	102	105	LITE COLOR CLAY & SHALE
8	18	LITE COLOR CLAY	105	108	HARD LITE COLOR LIMESTONE
18	24	GRAY & MAROON CLAY MIXED	108	121	LITE COLOR SHALE & CLAY
24	35	LITE COLOR CLAY & SHALE	121	140	MAROON SHALE & CLAY
35	40	LITE COLOR LIMESTONE	140	143	LITE COLOR SHALE & CLAY
40	45	LITE COLOR SHALE & CLAY	143	148	DARK SOFT CLAY
45	52	GRAY SHALE & CLAY	148	153	DARK GRAY SHALE
52	54	LITE COLOR LIMESTONE	153	162	GRAY LIMESTONE
54	57	LITE COLOR SHALE			
57	72	MAROON SHALE & BROWN			
72	80	LITE COLOR & LITE GRAY SHALE & CLAY			
80	95	HARD LITE COLOR LIMESTONE			
95	99	LITE COLOR SHALE			

7 CONTRACTOR'S OR LANDOWNER'S CERTIFICATION: This water well was (1) constructed, (2) reconstructed, or (3) plugged under my jurisdiction and was completed on (mo/day/year) 7 / 11 / 05 and this record is true to the best of my knowledge and belief. Kansas Water Well Contractor's Licence No 397 This Water Well Record was completed on (mo/day/yr) 7 / 20 / 05
under the business name of CENTRAL KANSAS DRILLING by (signature) Harold D. Martin

INSTRUCTIONS: Use typewriter or ball point pen. *PLEASE PRESS FIRMLY* and *PRINT* clearly. Please fill in blanks, underline or circle the correct answers. Send top three copies to Kansas Department of Health and Environment, Bureau of Water, Geology Section, 1000 SW Jackson St., Suite 420, Topeka, Kansas 66612-1367. Telephone 785-296-5522. Send one to WATER WELL OWNER and retain one for your records. Fee of $5.00 for each constructed well.