

WATER WELL RECORD Form WWC-5


Division of Water Resources App. No.

Well ID

Original Record Correction Change in Well Use

1 LOCATION OF WATER WELL: County: Dickinson Co. NW 1/4 NE 1/4 Fraction 1/4 Section Number 15 Township Number T 11 S Range Number R 4 E W

2 WELL OWNER: Last Name: ATHINS First: RYAN Street or Rural Address where well is located (if unknown, distance and direction from nearest town or intersection): From Chapman 8 miles north on Highway 1 to 3490 Rd. 2 miles east to trail rd. 1 mile north on 3500 Ave. 1/2 mile east where south
 Business: 7 Forsyth APTA.
 Address: FT. RILEY State: KS ZIP: 66442

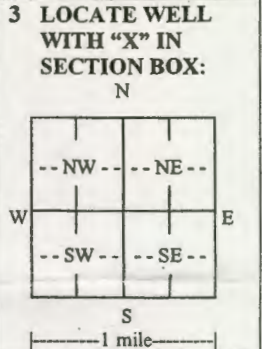

4 DEPTH OF COMPLETED WELL: 140 ft.
 Depth(s) Groundwater Encountered: 1) ft.
 2) ft. 3) ft., or 4) Dry Well
WELL'S STATIC WATER LEVEL: 80 ft.
 below land surface, measured on (mo-day-yr) 3/3/2023
 above land surface, measured on (mo-day-yr)
 Pump test data: Well water was ft.
 after hours pumping gpm
 Well water was ft.
 after hours pumping gpm
 Estimated Yield: 20 gpm
 Bore Hole Diameter: in. to 140 ft. and
 in. to ft.

5 Latitude: N 39° 06.143 (decimal degrees)
Longitude: W 096° 58.286 (decimal degrees)
 Horizontal Datum: WGS 84 NAD 83 NAD 27
 Source for Latitude/Longitude: GPS (unit make/model: Garmin Etrex 20)
 Land Survey Topographic Map
 Online Mapper:
6 Elevation: 1260 ft. Ground Level TOC
 Source: Land Survey GPS Topographic Map
 Other

7 WELL WATER TO BE USED AS:

1. Domestic: Household Lawn & Garden Livestock
 2. Irrigation
 3. Feedlot
 4. Industrial
 5. Public Water Supply: well ID
 6. Dewatering: how many wells?
 7. Aquifer Recharge: well ID
 8. Monitoring: well ID
 9. Environmental Remediation: well ID
 Air Sparge Soil Vapor Extraction
 Recovery Injection
 10. Oil Field Water Supply: lease
 11. Test Hole: well ID
 Cased Uncased Geotechnical
 12. Geothermal: how many bores?
 a) Closed Loop Horizontal Vertical
 b) Open Loop Surface Discharge Inj. of Water
 13. Other (specify):

Was a chemical/bacteriological sample submitted to KDHE? Yes No If yes, date sample was submitted:
 Water well disinfected? Yes No

8 TYPE OF CASING USED: Steel PVC Other CASING JOINTS: Glued Clamped Welded Threaded
 Casing diameter 5 1/2 in. to 120 ft., Diameter in. to ft., Diameter in. to ft.
 Casing height above land surface 3 in. Weight 52.40 lbs./ft. Wall thickness or gauge No.

TYPE OF SCREEN OR PERFORATION MATERIAL:
 Steel Stainless Steel Fiberglass PVC Other (Specify)
 Brass Galvanized Steel Concrete tile None used (open hole)

SCREEN OR PERFORATION OPENINGS ARE:
 Continuous Slot Mill Slot Gauze Wrapped Torch Cut Drilled Holes Other (Specify)
 Louvered Shutter Key Punched Wire Wrapped Saw Cut None (Open Hole)

SCREEN-PERFORATED INTERVALS: From 120 ft. to 140 ft., From ft. to ft., From ft. to ft.
GRAVEL PACK INTERVALS: From 45 ft. to 140 ft., From ft. to ft., From ft. to ft.

9 GROUT MATERIAL: Neat cement Cement grout Bentonite Other
 Grout Intervals: From 5 ft. to 45 ft., From ft. to ft., From ft. to ft.

Nearest source of possible contamination: None Close
 Septic Tank Lateral Lines Pit Privy Livestock Pens Insecticide Storage
 Sewer Lines Cess Pool Sewage Lagoon Fuel Storage Abandoned Water Well
 Watertight Sewer Lines Seepage Pit Feedyard Fertilizer Storage Oil Well/Gas Well
 Other (Specify)
 Direction from well? Distance from well? ft.

10 FROM	TO	LITHOLOGIC LOG	FROM	TO	LITHO. LOG (cont.) or PLUGGING INTERVALS
0	1	Top Soil			
1	4	Brown Clay			
4	23	Limestone			
23	72	Brown Shale			
72	86	Limestone			
86	106	Brown Shale			
106	111	Limestone			
111	140	Brown Shale			

11 CONTRACTOR'S OR LANDOWNER'S CERTIFICATION: This water well was constructed, reconstructed, or plugged under my jurisdiction and was completed on (mo-day-yr) 3/3/2023 and this record is true to the best of my knowledge and belief. Kansas Water Well Contractor's License No. 481. This Water Well Record was completed on (mo-day-yr) 3/6/2023 under the business name of Haldeman Well Drilling

Mail 1 white copy along with a fee of \$5.00 for each constructed well to: Kansas Department of Health and Environment, Bureau of Water, GWIS Section, 1000 SW Jackson St., Suite 420, Topeka, Kansas 66612-1367. Mail one to Water Well Owner and retain one for your records. Telephone 785-296-5524.