


1 LOCATION OF WATER WELL: County: Clay Fraction: NE 1/4 SE 1/4 SE 1/4 Section Number: 28 Township Number: T 11 S Range Number: R 5 E

Distance and direction from nearest town or city street address of well if located within city? From J.C. 60 3 miles N.W. on 57 Highway to 77

2 WATER WELL OWNER: Byron Johnson  
 RR#, St. Address, Box #: 57+77  
 City, State, ZIP Code: Junction City, KS 66441  
 Board of Agriculture, Division of Water Resources  
 Application Number:

3 LOCATE WELL'S LOCATION WITH AN "X" IN SECTION BOX:

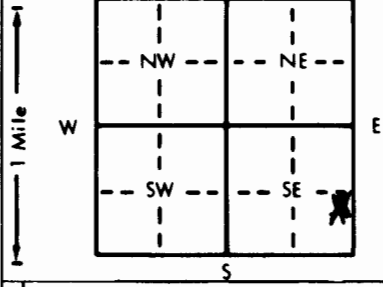

4 DEPTH OF COMPLETED WELL: 32 ft. ELEVATION:

Depth(s) Groundwater Encountered 1. 16 ft. 2. . . . . ft. 3. . . . . ft.  
 WELL'S STATIC WATER LEVEL . . . 16 ft. below land surface measured on mo/day/yr  
 Pump test data: Well water was . . . . . ft. after . . . . . hours pumping . . . . . gpm  
 Est. Yield 50 gpm: Well water was . . . . . ft. after . . . . . hours pumping . . . . . gpm  
 Bore Hole Diameter 10 in. to 32 in. to . . . . . in. to . . . . . ft.  
 WELL WATER TO BE USED AS: 5 Public water supply 8 Air conditioning 11 Injection well  
 1 Domestic 3 Feedlot 6 Oil field water supply 9 Dewatering 12 Other (Specify below)  
 2 Irrigation 4 Industrial 7 Lawn and garden only 10 Monitoring well . . . . .

5 TYPE OF BLANK CASING USED:  
 1 Steel 3 RMP (SR) 5 Wrought iron 8 Concrete tile CASING JOINTS: Glued . . . . . Clamped . . . . .  
 2 PVC 4 ABS 6 Asbestos-Cement 9 Other (specify below) Welded . . . . .  
 7 Fiberglass . . . . . Threaded . . . . .

Blank casing diameter . . . 5 in. to 20 in. Dia . . . . . in. to . . . . . in. Dia . . . . . in. to . . . . . ft.  
 Casing height above land surface . . . 2 in., weight Sch. 40 lbs./ft. Wall thickness or gauge No. . . . .

TYPE OF SCREEN OR PERFORATION MATERIAL:  
 1 Steel 3 Stainless steel 5 Fiberglass 7 PVC 10 Asbestos-cement  
 2 Brass 4 Galvanized steel 6 Concrete tile 8 RMP (SR) 11 Other (specify) . . . . .  
 9 ABS 12 None used (open hole)

SCREEN OR PERFORATION OPENINGS ARE:  
 1 Continuous slot 3 Mill slot 5 Gauzed wrapped 8 Saw cut 11 None (open hole)  
 2 Louvered shutter 4 Key punched 6 Wire wrapped 9 Drilled holes  
 7 Torch cut 10 Other (specify) . . . . .

SCREEN-PERFORATED INTERVALS: From . . . 20 ft. to 32 ft. . . . . ft. From . . . . . ft. to . . . . . ft.  
 From . . . . . ft. to . . . . . ft. From . . . . . ft. to . . . . . ft.  
 GRAVEL PACK INTERVALS: From . . . 20 ft. to 32 ft. . . . . ft. From . . . . . ft. to . . . . . ft.  
 From . . . . . ft. to . . . . . ft. From . . . . . ft. to . . . . . ft.

6 GROUT MATERIAL: 1 Neat cement 2 Cement grout 3 Bentonite 4 Other . . . . .  
 Grout intervals: From . . . 0 ft. to 20 ft. From . . . . . ft. to . . . . . ft. From . . . . . ft. to . . . . . ft.

What is the nearest source of possible contamination:  
 1 Septic tank 4 Lateral lines None at loss 10 Livestock pens 14 Abandoned water well  
 2 Sewer lines 5 Cess pool 8 Sewage lagoon 11 Fuel storage 15 Oil well/Gas well  
 3 Watertight sewer lines 6 Seepage pit 9 Feedyard 12 Fertilizer storage 16 Other (specify below)  
 13 Insecticide storage . . . . .

Direction from well? How many feet?

FROM	TO	LITHOLOGIC LOG	FROM	TO	PLUGGING INTERVALS
0	11	Sandy Clay			
11	14	Fine Sand			
14	16	Medium Sand			
16	32	Coarse Sand + Gravel			

7 CONTRACTOR'S OR LANDOWNER'S CERTIFICATION: This water well was (1) constructed, (2) reconstructed, or (3) plugged under my jurisdiction and was completed on (mo/day/year) 4/9/96 and this record is true to the best of my knowledge and belief. Kansas Water Well Contractor's License No. 451 This Water Well Record was completed on (mo/day/yr) 5/28/196 under the business name of Holden Will Drilling by (signature) [Signature]