

USE TYPEWRITER OR BALL POINT PEN-PRESS FIRMLY, PRINT CLEARLY.

WATER WELL RECORD
KSA 82a-1201-1215


Kansas Department of Health and Environment-Division of Environment (Water well Contractors) Topeka, Kansas 66620

meadows
Lot 10 Block 2 in Country Subdivision

1. Location of well: County Geary Fraction NW 1/4 SE 1/4 Section number 9 Township number T 1 South Range number R 5 East of 6th PM

2. Distance and direction from nearest town or city: 3 miles north on Highway about 79 north on west side of Street address of well location if in city: at Country meadows

3. Owner of well: Geo Ridd R.R. or street: Dwight Kans City, state, zip code: Dwight Kans

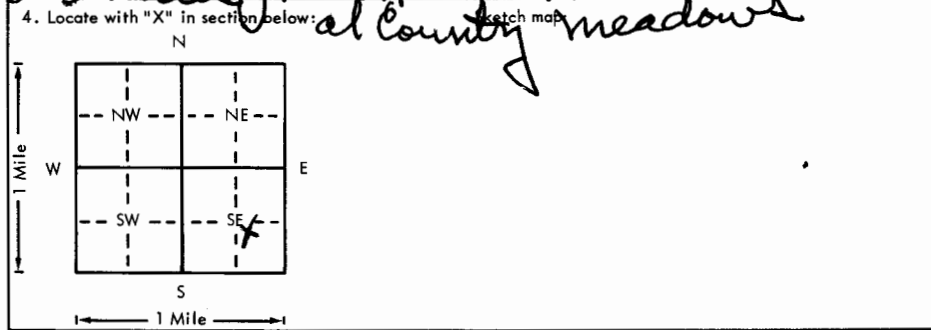

6. Bore hole dia. 4 1/2 in. Completion date 3-29-78
Well depth 106 ft.

7. Cable tool Rotary Driven Dug
 Hollow rod Jetted Bored Reverse rotary

8. Use: Domestic Public supply Industry
 Irrigation Air conditioning Stock
 Lawn Oil field water Other

9. Casing: Material PVC Height: (Above or below) 0
Threaded Welded Surface 2 1/2 in.
RMP PVC Weight 26 lbs/ft
Dia. 5 in. to 100 ft. depth Wall Thickness: inches or
Dia. 5 in. to 100 ft. depth gage No. Wall

5. Type and color of material	From	To
<u>top soil, Black</u>	<u>1</u>	<u>5</u>
<u>Sand, yellow fine</u>	<u>5</u>	<u>15</u>
<u>clay, joint</u>	<u>15</u>	<u>25</u>
<u>clay, Red</u>	<u>25</u>	<u>60</u>
<u>Rock, yellow limestone</u>	<u>60</u>	<u>66</u>
<u>Water B6' Rock, yellow limestone</u>	<u>66</u>	<u>86</u>
<u>Shale, Blue</u>	<u>86</u>	<u>106</u>

10. Screen: Manufacturer's name M.P.I.
Type PVC Dia. 3"
Slot 0.040 Length 40'
Set between 106 ft. and 66 ft.
Gravel pack? Size range of material XX

11. Static water level: 70 ft. below land surface Date 3-29-78

12. Pumping level below land surfaces:
70 ft. after 15 hrs. pumping 15 g.p.m.
Estimated maximum yield 15 g.p.m.

13. Water sample submitted: 1 mo./day/yr.
 Yes No Date NA

14. Well head completion: NA
 Pitless adapter Inches above grade

15. Well grouted? 1 1/2
With: Neat cement Bentonite Concrete
Depth: From 15 ft. to 5 ft.

16. Nearest source of possible contamination: 100 ft. Direction WEST Type Septic tank
Well disinfected upon completion? Yes No

17. Pump: Not installed
Manufacturer's name _____ HP _____ Volts _____
Length of drop pipe _____ ft. capacity _____ g.p.m.
Type: Submersible Turbine
 Jet Reciprocating
 Centrifugal Other

18. Elevation: _____

19. Remarks: _____

20. Water well contractor's certification: This well was drilled under my jurisdiction and this report is true to the best of my knowledge and belief.
Strader Drilling Co 23
Business name Blue Rapids Kas License No. _____
Address Harold Strader Date 3-29-78
Signed Harold Strader Authorized representative

meadows
T
R
S
Sec
35 35
NW
1/4
1/4
1/4