USE TYPEWRITER OR BALL POINT PEN-PRESS FIRMLY, PRINT CLEARLY.

WATER WELL RECORD
KSA 82a-1201-1215

Kansas Department of Health and Environment-Division of Environment
(Water well Contractors)
Topeka, Kansas 66620

SE¼ SE¼ NE¼

1. Location of well:	County: Geary	Fraction: N, E ¼ (1/4 1/4 1/4)	Section number: 9	Township number: T 11 South S	Range number: R 5 east E/W

2. Distance and direction from nearest town or city: N.W. Junction City to Robt Laurence trailer Court
Street address of well location if in city: Lot NO 26

3. Owner of well: Charles Davis Milford
R.R. or street: Rolling Hills
City, state, zip code: ~~Junction City~~ Kans

4. Locate with "X" in section below:

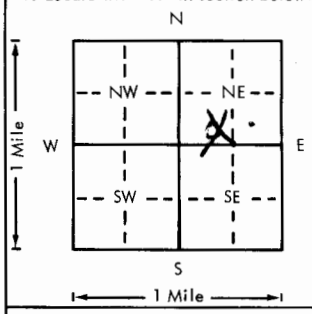

Sketch map:

6. Bore hole dia. 10 in. Completion date 7-8-77
Well depth 115 ft.

7. X Cable tool __ Rotary __ Driven __ Dug
__ Hollow rod __ Jetted __ Bored __ Reverse rotary

8. Use: X Domestic __ Public supply __ Industry
__ Irrigation __ Air conditioning __ Stock
__ Lawn __ Oil field water __ Other

9. Casing: Material PVC Height: Above or below
Threaded ___ Welded ___ Surface 14 in.
RMP ___ PVC ___ Weight 200 lbs./ft.
Dia. 5 in. to 115 ft. depth Wall Thickness: inches or
Dia. ___ in. to ___ ft. depth gage No. .258 MHC

10. Screen: Manufacturer's name M.P.I. ~~Pumpco~~
Type PVC Dia. 5
Slot/gauze .060 Length 40
Set between 110 ft. and 70 ft.
___ ft. and ___ ft.
Gravel pack? X Size range of material ~~1/8~~ X 1/4

11. Static water level: 50 ft. below land surface Date 7-8-77 mo./day/yr.

12. Pumping level below land surfaces:
___ ft. after ___ hrs. pumping ___ g.p.m.
___ ft. after ___ hrs. pumping ___ g.p.m.
Estimated maximum yield 15 g.p.m.

13. Water sample submitted: mo./day/yr.
__ Yes X No Date

14. Well head completion: NA
__ Pitless adapter ___ Inches above grade

15. Well grouted? X
With: X MHC Neat cement ___ Bentonite ___ Concrete
Depth: From 18 ft. to 4 ft.

16. Nearest source of possible contamination:
ft. 100 Direction NE Type Septic tank
Well disinfected upon completion? X Yes ___ No

17. Pump: X Not installed
Manufacturer's name
Model number ___ HP ___ Volts ___
Length of drop pipe ___ ft. capacity ___ g.p.m.
Type:
__ Submersible __ Turbine
__ Jet __ Reciprocating
__ Centrifugal __ Other

5. Type and color of material

From	To
Sand Fine yellow	1	3
Clay Red	3	32
Rock Yellow Limestone	32	62
Rock Blue Shaley	62	91
Rock White Lime	91	97
Shale Blue	97	115

(Use a second sheet if needed)

18. Elevation:
Topography:
__ Hill
__ Slope
X Upland
__ Valley

19. Remarks:

20. Water well contractor's certification:
This well was drilled under my jurisdiction and this report is true to the best of my knowledge and belief.
Strader Drilling Co 237
Business name License No.
Address Blue Rapids
Signed Harold Strader Date 7-8-77
Authorized representative

T 11 R 5 W Sec 9 1/4 SE SE NE

Forward the white, blue and pink copies to the Department of Health and Environment

Form WWC-5