


RR 3, Junction City, KS

mw-2

RR#, St. Address, Box # : **PO BOX 1876**
City, State, ZIP Code : **Junction City, KS 66441**

Application Number:

4 DEPTH OF COMPLETED WELL 23.3 ft. ELEVATION: 1073.29

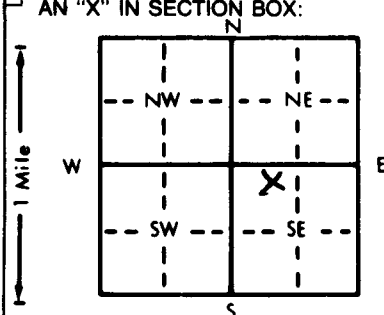

Depth(s) Groundwater Encountered 1. . . . 1 ft. 2. . . . — ft. 3. . . . 2 ft.

Pump test data: Well water was ft. after hours pumping gpm

Bore Hole Diameter . . . 8 . . . in. to . . . 25.5 . . . ft., and . . . — . . . in. to . . . — . . . ft.

1 Domestic	3 Feedlot	6 Oil field water supply	9 Dewatering	12 Other (Specify below)
------------	-----------	--------------------------	--------------	--------------------------

Was a chemical/bacteriological sample submitted to Department? Yes..... No X..... If yes, mo/day/vr sample was sub-

Water Well Disinfected? Yes ☐ No ☒

CASING JOINTS: Glued Clamped

Casing height above land surface - 1.2 in. weight = lbs./ft. Wall thickness or gauge No. 40

SCREEN OR PERFORATION OPENINGS ARE:

2 Louvered shutter 4 Key punched 7 Torch cut 10 Other (specify) _____
SCREEN PERFORATED INTERVALS From 23.3 " to 13.3 " From — " to — "

From 355 ft. to 40 ft. From 40 ft. to 45 ft.

From 1 ft. to 1 ft., From 1 ft. to 1 ft.

Grout Intervals: From 11.0 ft. to 1.0 ft., From ft. to ft., From ft. to ft.

1 Septic tank	4 Lateral lines	7 Pit privy	11 Fuel storage	15 Oil well/Gas well
---------------	-----------------	-------------	-----------------	----------------------

3 Watertight sewer lines	6 Seepage pit	9 Feedyard	13 Insecticide storage	
--------------------------	---------------	------------	------------------------	-------

FROM	TO	LITHOLOGIC LOG	FROM	TO	PLUGGING INTERVALS
------	----	----------------	------	----	--------------------

0.7	3.0	DARK GREY SILTY CLAY			
-----	-----	----------------------	--	--	--

7.0	20.5	21. BROWN FINE GRAIN SAND			
-----	------	---------------------------	--	--	--

1	2	
---	---	---	---	---	---	---	---	---	----	----	-----

[illegible][illegible][illegible][illegible]

1	2	
---	---	---	---	---	---	---	---	---	----	----	-----	-----	

completed on (mo/day/year) 5-5-93 and this record is true to the best of my knowledge and belief. Kansas

under the business name of MIKON Corporation by (signature) David Kramer

of Health and Environment, Bureau of Water, Topeka, Kansas 66620-0001. Telephone: 913-296-5545. Send one to WATER WELL OWNER and retain one for your records.
