


1 LOCATION OF WATER WELL: Fraction $\frac{1}{4}$ S $\frac{1}{4}$ NW $\frac{1}{4}$ Section Number 21 Township Number T 11 S Range Number R 50 EW
 County: Geary
 Distance and direction from nearest town or city street address of well if located within city? 2 mis. South $\frac{1}{2}$ mile East of Milford; due East of Dam

2 WATER WELL OWNER: State of KS Fish & Game Commission
 RR#, St. Address, Box #: Corps. of Engrs., 700 Fed. Bldg.
 City, State, ZIP Code: Kansas City, Mo. 64106
 Board of Agriculture, Division of Water Resources
 Application Number: 35,611

3 LOCATE WELL'S LOCATION WITH AN "X" IN SECTION BOX:

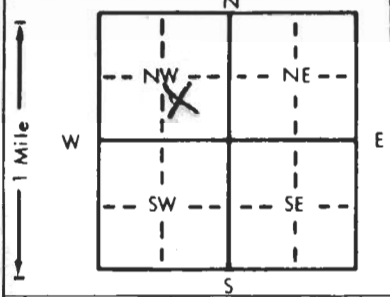

4 DEPTH OF COMPLETED WELL... 46.0... ft. ELEVATION: ... 1.072.2...
 Depth(s) Groundwater Encountered 1. ft. 2. ft. 3. ft.
 WELL'S STATIC WATER LEVEL ... 4.0... ft. below land surface measured on mo/day/yr ... 12/1/83...
 Pump test data: Well water was ft. after hours pumping gpm
 Est. Yield 1,000 gpm: Well water was ft. after hours pumping gpm
 Bore Hole Diameter, 30 in. to ft., and in. to ft.
 WELL WATER TO BE USED AS: 5 Public water supply 8 Air conditioning 11 Injection well
 1 Domestic 3 Feedlot 6 Oil field water supply 9 Dewatering 12 Other (Specify below)
 2 Irrigation 4 Industrial 7 Lawn and garden only 10 Observation well
 Was a chemical/bacteriological sample submitted to Department? Yes.....No. X.....; If yes, mo/day/yr sample was submitted
 Water Well Disinfected? Yes No X

5 TYPE OF BLANK CASING USED: 5 Wrought iron 8 Concrete tile CASING JOINTS: Glued Clamped
 1 Steel 3 RMP (SR) 6 Asbestos-Cement 9 Other (specify below) Welded
 2 PVC 4 ABS 7 Fiberglass Threaded
 Blank casing diameter 16 in. to 18.0 ft., Dia. in. to ft., Dia. in. to ft.
 Casing height above land surface 10 in., weight 32.0 lbs./ft. Wall thickness or gauge No. 250"

TYPE OF SCREEN OR PERFORATION MATERIAL: 7 PVC 10 Asbestos-cement
 1 Steel 3 Stainless steel 5 Fiberglass 8 RMP (SR) 11 Other (specify)
 2 Brass 4 Galvanized steel 6 Concrete tile 9 ABS 12 None used (open hole)

SCREEN OR PERFORATION OPENINGS ARE: 5 Gauzed wrapped 8 Saw cut 11 None (open hole)
 1 Continuous slot 3 Mill slot 6 Wire wrapped 9 Drilled holes
 2 Louvered shutter 4 Key punched 7 Torch cut 10 Other (specify)

SCREEN-PERFORATED INTERVALS: From 28.0 ft. to 46.0 ft., From ft. to ft.
 From ft. to ft., From ft. to ft.
 GRAVEL PACK INTERVALS: From 5.0 ft. to 46.0 ft., From ft. to ft.
 From ft. to ft., From ft. to ft.

6 GROUT MATERIAL: 1 Neat cement 2 Cement grout 3 Bentonite 4 Other compacted clay backfill
 Grout Intervals: From 0 ft. to 5.0 ft., From ft. to ft., From ft. to ft.
 What is the nearest source of possible contamination: 10 Livestock pens 14 Abandoned water well
 1 Septic tank 4 Lateral lines 7 Pit privy 11 Fuel storage 15 Oil well/Gas well
 2 Sewer lines 5 Cess pool 8 Sewage lagoon 12 Fertilizer storage 16 Other (specify below)
 3 Watertight sewer lines 6 Seepage pit 9 Feedyard 13 Insecticide storage
 Direction from well? 465' west How many feet? 465'

FROM	TO	LITHOLOGIC LOG	FROM	TO	LITHOLOGIC LOG
0	4	Fine dry sand			
4	10	medium sand			
10	20	coarse sand			
20	30	coarse sand			
30	40	very coarse gravel and cobbles			
40	46	very coarse gravel and cobbles			
46		limestone			

7 CONTRACTOR'S OR LANDOWNER'S CERTIFICATION: This water well was (1) constructed, (2) reconstructed, or (3) plugged under my jurisdiction and was completed on (mo/day/year) 12/1/83 and this record is true to the best of my knowledge and belief. Kansas Water Well Contractor's License No. 499 This Water Well Record was completed on (mo/day/yr) 12/28/83 under the business name of Subgrade Const. Co. by (signature) Ray D. Newson
 INSTRUCTIONS: Use typewriter or ballpoint pen, PLEASE PRESS FIRMLY and PRINT clearly. Please fill in blanks, underline or circle the correct answers. Send top three copies to Kansas Department of Health and Environment, Division of Environment, Environmental Geology Section, Topeka, KS 66620. Send one to WATER WELL OWNER and retain one for your records.