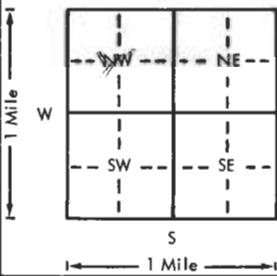
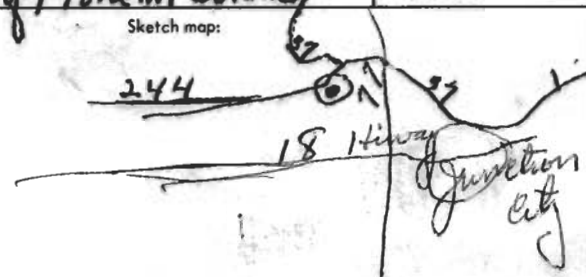


USE TYPEWRITER OR BALL POINT PEN-PRESS FIRMLY, PRINT CLEARLY.

WATER WELL RECORD
KSA 82a-1201-1215

Kansas Department of Health and Environment-Division of Environment
(Water well Contractors)
Topeka, Kansas 66620

1. Location of well: County <u>Leary</u>		Fraction <u>NW 1/4 of NW 1/4</u> 1/4 1/4 1/4		Section number <u>32</u>		Township number <u>T 149</u>		Range number <u>R 5 east of 6</u> E/W	
2. Distance and direction from nearest town or city: <u>Junction City, Mo.</u> <u>on Highway 244 West of 770 N.E. 1 So. side</u>				3. Owner of well: <u>Keno Maxon</u> R.R. or street: <u>R. 7. D. 1</u> City, state, zip code: <u>Mulford, Kans</u>					
4. Locate with "X" in section below: 				Sketch map: 		6. Bore hole dia. <u>7.75</u> in. Completion date <u>4-13-76</u> Well depth <u>129</u> ft.			
				7. <input checked="" type="checkbox"/> Cable tool <input type="checkbox"/> Rotary <input type="checkbox"/> Driven <input type="checkbox"/> Dug <input type="checkbox"/> Hollow rod <input type="checkbox"/> Jetted <input type="checkbox"/> Bored <input type="checkbox"/> Reverse rotary					
				8. Use: <input checked="" type="checkbox"/> Domestic <input type="checkbox"/> Public supply <input type="checkbox"/> Industry <input type="checkbox"/> Irrigation <input type="checkbox"/> Air conditioning <input type="checkbox"/> Stock <input type="checkbox"/> Lawn <input type="checkbox"/> Oil field water <input type="checkbox"/> Other					
				9. Casing: Material <u>PVC</u> Height: <u>Above</u> or below Threaded <input type="checkbox"/> Welded <input type="checkbox"/> Surface <u>12</u> in. RMP <input type="checkbox"/> PVC <input checked="" type="checkbox"/> Weight <u>160</u> lbs./ft. Dia. <u>5</u> in. to <u>129</u> ft. depth; Wall thickness: inches or Dia. <u> </u> in. to <u> </u> ft. depth; gage No. <u> </u>					
5. Type and color of material				From		To			
<u>T of Soil</u>				<u>0</u>		<u>1</u>			
<u>limestone Rock</u>				<u>1</u>		<u>68</u>			
<u>Blue shale</u>				<u>68</u>		<u>82</u>			
<u>Red shale</u>				<u>82</u>		<u>89</u>			
<u>Blue shale</u>				<u>89</u>		<u>129</u>			
				10. Screen: Manufacturer's name <u>Pumped</u> Type <u>PVC</u> Dia. <u>5</u> Slot/gauze <u>0.40</u> Length <u>40</u> Set between <u>75</u> ft. and <u>115</u> ft. ft. and <u> </u> ft. Gravel pack? <u>no</u> Size range of material <u> </u>					
				11. Static water level: <u>80</u> ft. below land surface Date <u>4-13-76</u> no./day/yr. <u> </u>					
				12. Pumping level below land surfaces: <u> </u> ft. after <u> </u> hrs. pumping <u> </u> g.p.m. <u> </u> ft. after <u> </u> hrs. pumping <u> </u> g.p.m. Estimated maximum yield <u>2.4</u> g.p.m.					
				13. Water sample submitted: <u> </u> mo./day/yr. Yes <input checked="" type="checkbox"/> No <input type="checkbox"/> Date <u> </u>					
				14. Well head completion: <u>NA</u> <input type="checkbox"/> Pitless adapter <u> </u> inches above grade					
				15. Well grouted? <input checked="" type="checkbox"/> With: <input type="checkbox"/> Neat cement <input type="checkbox"/> Bentonite <input checked="" type="checkbox"/> Concrete Depth: From <u>4</u> ft. to <u>15</u> ft.					
				16. Nearest source of possible contamination: <u>pasture</u> ft. <u>150</u> Direction <u>150</u> Type <u>pasture</u> Well disinfected upon completion? <input checked="" type="checkbox"/> Yes <input type="checkbox"/> No					
				17. Pump: <input checked="" type="checkbox"/> Not installed Manufacturer's name <u> </u> Model number <u> </u> HP <u> </u> Volts <u> </u> Length of drop pipe <u> </u> ft. capacity <u> </u> g.p.m. Type: <input type="checkbox"/> Submersible <input type="checkbox"/> Turbine <input type="checkbox"/> Jet <input type="checkbox"/> Reciprocating <input type="checkbox"/> Centrifugal <input type="checkbox"/> Other					
(Use a second sheet if needed)									
18. Elevation:		19. Remarks:							
Topography: <input checked="" type="checkbox"/> Hill <input type="checkbox"/> Slope <input type="checkbox"/> Upland <input type="checkbox"/> Valley									
		20. Water well contractor's certification: This well was drilled under my jurisdiction and this report is true to the best of my knowledge and belief. <u>Strader Drilling Co 937</u> Business name <u>Blue Rapids</u> License No. <u> </u> Address <u>Harold Strader</u> Signed <u>Harold Strader</u> Date <u>4-13-76</u> Authorized representatives							

Forward the white, blue and pink copies to the Department of Health and Environment

Form WWC-5