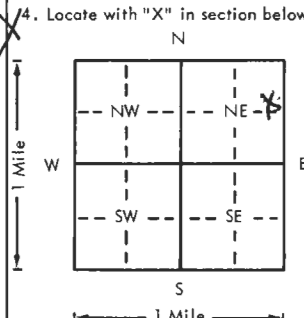


USE TYPEWRITER OR BALL POINT PEN—PRESS FIRMLY, PRINT CLEARLY.

WATER WELL RECORD
KSA 82a-1201-1215

Kansas Department of Health and Environment—Division of Environment
(Water well Contractors)
Topeka, Kansas 66620

1. Location of well: County Geary Fraction NE 1/4 1/4 1/4 Section number 33 Township number T 11 S Range number R 5 E E/W	
2. Distance and direction from nearest town or city: West of 77 H₁ 3. Owner of well: Robert Meyer Street address of well location if in city: 229 W 15th Junction City KS City, state, zip code: Junction City KS	
4. Locate with "X" in section below: Sketch map: 	
5. Type and color of material	
	From To
topsoil	0 4
clay	4 10
Rock	10 17
Shale, Blue	17 60
Rock Limestone	60 79
Blue Shale	79 93
(Use a second sheet if needed)	
18. Elevation: Topography: <input type="checkbox"/> Hill <input checked="" type="checkbox"/> Slope <input type="checkbox"/> Upland <input type="checkbox"/> Valley	19. Remarks:
20. Water well contractor's certification: This well was drilled under my jurisdiction and this report is true to the best of my knowledge and belief. Strader Drilling Co 237 Business name Blue Rapids License No. _____ Address _____ Signed Harold Strader Date 9-2-76 Authorized representative	

6. Bore hole dia. **10** in. Completion date **9-2-76**
Well depth **93** ft.

7. Cable tool Rotary Driven Dug
 Hollow rod Jetted Bored Reverse rotary

8. Use: Domestic Public supply Industry
 Irrigation Air conditioning Stock
 Lawn Oil field water Other

9. Casing: Material **PVC** Height **(Above or below)**
Threaded Welded Surface **T2** in.
RMP PVC Weight _____ lbs./ft.
Dia. **5** in. to **93** ft. depth Wall Thickness: inches or
Dia. _____ in. to _____ ft. depth gage No. **Sch 40**

10. Screen: Manufacturer's name **Pumped**
Type **pvc** Dia. **5**
Slot/gauze **.040** Length **40'**
Set between **45** ft. and **85** ft.
Gravel pack? Size range of material **1/8 X 1/4**

11. Static water level: _____ mo./day/yr.
70 ft. below land surface Date **9-2-76**

12. Pumping level below land surfaces:
_____ ft. after _____ hrs. pumping _____ g.p.m.
_____ ft. after _____ hrs. pumping _____ g.p.m.
Estimated maximum yield **6** g.p.m.

13. Water sample submitted: _____ mo./day/yr.
Yes No Date _____

14. Well head completion: **NA**
 Pitless adapter _____ Inches above grade

15. Well grouted?
With: Neat cement Bentonite Concrete
Depth: From **14** ft. to **4** ft.

16. Nearest source of possible contamination:
ft. **120** Direction **West** Type **Septic tank**
Well disinfected upon completion? Yes No

17. Pump: Not installed
Manufacturer's name _____
Model number _____ HP _____ Volts _____
Length of drop pipe _____ ft. capacity _____ g.p.m.
Type:
 Submersible Turbine
 Jet Reciprocating
 Centrifugal Other

T 11 S
R 5 E
W 15
Sec 33 NE 1/4 1/4 1/4