


1 LOCATION OF WATER WELL: County: GEARY Fraction: SE 1/4 SE 1/4 SW 1/4 Section Number: 33 Township Number: T 11 S Range Number: R 5 E

Distance and direction from nearest town or city street address of well if located within city? Highway 18 = 1/2 mile west to 99 & 60 West 2 1/2 mile
Go North 1 mile to County Road

2 WATER WELL OWNER: SCOTT T. JOHNSON
 RR#, St. Address, Box #: RR #1 Box 99A
 City, State, ZIP Code: Milford, Kansas 66514
 Board of Agriculture, Division of Water Resources
 Application Number:

3 LOCATE WELL'S LOCATION WITH AN "X" IN SECTION BOX: SW 1/4

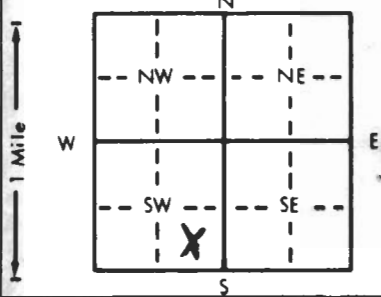

4 DEPTH OF COMPLETED WELL: 140 ft. ELEVATION:
 Depth(s) Groundwater Encountered: 1 9.4 ft. 2. ft. 3. ft.
 WELL'S STATIC WATER LEVEL: 90 ft. below land surface measured on mo/day/yr
 Pump test data: Well water was ft. after hours pumping gpm
 Est. Yield: 3.5 gpm; Well water was ft. after hours pumping gpm
 Bore Hole Diameter: 8 in. to 140' ft., and in. to ft.
 WELL WATER TO BE USED AS:
 1 Domestic 3 Feedlot 6 Oil field water supply 9 Dewatering 12 Other (Specify below)
 2 Irrigation 4 Industrial 7 Lawn and garden only 10 Observation well
 Was a chemical/bacteriological sample submitted to Department? Yes No If yes, mo/day/yr sample was submitted
 Water Well Disinfected? Yes No

5 TYPE OF BLANK CASING USED:
 1 Steel 3 RMP (SR) 5 Wrought iron 8 Concrete tile CASING JOINTS: Glued Clamped
 2 PVC 4 ABS 6 Asbestos-Cement 9 Other (specify below) Welded Sealed
 7 Fiberglass Threaded

Blank casing diameter: 8.5 in. to 120 ft., Dia. in. to ft., Dia. in. to ft.
 Casing height above land surface: 2' in., weight 50 lb. lbs./ft. Wall thickness or gauge No.

TYPE OF SCREEN OR PERFORATION MATERIAL:
 1 Steel 3 Stainless steel 5 Fiberglass 7 PVC 10 Asbestos-cement
 2 Brass 4 Galvanized steel 6 Concrete tile 8 RMP (SR) 11 Other (specify)
 12 None used (open hole)

SCREEN OR PERFORATION OPENINGS ARE:
 1 Continuous slot 3 Mill slot 3/1000" 5 Gauzed wrapped 8 Saw cut 11 None (open hole)
 2 Louvered shutter 4 Key punched 6 Wire wrapped 9 Drilled holes

SCREEN-PERFORATED INTERVALS: From 120 ft. to 140 ft., From ft. to ft.
 GRAVEL PACK INTERVALS: From 25 ft. to 140 ft., From ft. to ft.

6 GROUT MATERIAL: 1 Neat cement 2 Cement grout 3 Bentonite 4 Other
 Grout Intervals: From 5 ft. to 25 ft., From ft. to ft.

What is the nearest source of possible contamination:
 1 Septic tank 4 Lateral lines 7 Pit privy 10 Livestock pens 14 Abandoned water well
 2 Sewer lines 5 Cess pool 8 Sewage lagoon 11 Fuel storage 15 Oil well/Gas well
 3 Watertight sewer lines 6 Seepage pit 9 Feedyard 12 Fertilizer storage 16 Other (specify below)
 13 Insecticide storage

Direction from well? How many feet?

FROM	TO	LITHOLOGIC LOG	FROM	TO	LITHOLOGIC LOG
0	1	Top Soil	94	105	Rock
1	10	Brown Clay	105	107	Brown Shale
10	13	Grey Shale	107	125	Rock
13	16	Rock	125	129	Brown Shale
16	30	Grey Shale	129	134	Rock
30	32	Rock	134	140	Grey Blue Shale
32	35	Grey Shale			
35	36	Rock			
36	41	Grey Shale			
41	63	Rock			
63	71	Grey Shale			
71	88	Rock			
88	91	Grey Shale			
91	92	Rock			
92	94	Grey Shale			

7 CONTRACTOR'S OR LANDOWNER'S CERTIFICATION: This water well was (1) constructed, (2) reconstructed, or (3) plugged under my jurisdiction and was completed on (mo/day/year) 4/11/87 and this record is true to the best of my knowledge and belief, Kansas Water Well Contractor's License No. 451 This Water Well Record was completed on (mo/day/yr) 5/11/87 under the business name of Haldeman Well Drilling by (signature) Craig

INSTRUCTIONS: Use typewriter or ball point pen. PLEASE PRESS FIRMLY and PRINT clearly. Please fill in blanks, underline or circle the correct answers. Send top three copies to Kansas Department of Health and Environment, Bureau of Water Protection, Topeka, Kansas 66620-7320, Telephone: 913-862-9360. Send one to WATER WELL OWNER and retain one for your records.