


1 LOCATION OF WATER WELL: County: Geary Fraction: SW 1/4 SW 1/4 SW 1/4 Section Number: 33 Township Number: T 11(S) Range Number: R 5 E/W

Distance and direction from nearest town or city street address of well if located within city? Highway 18 at Junction City limits 5 Mile west To 77 Go North 1 mile To County Road & Go West 1 mile

2 WATER WELL OWNER: Scott Johnson RR#, St. Address, Box #: RR#1 Box 99A City, State, ZIP Code: Milford, Kansas 66514 Board of Agriculture, Division of Water Resources Application Number:

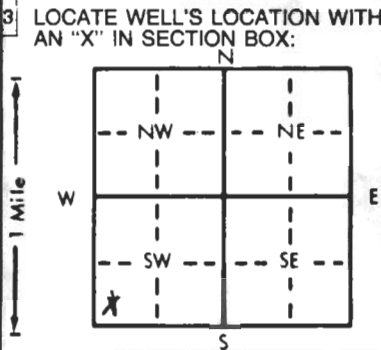

4 DEPTH OF COMPLETED WELL: 1.20 ft. ELEVATION: ft.
 Depth(s) Groundwater Encountered 1. 9.6 ft. 2. ft. 3. ft.
 WELL'S STATIC WATER LEVEL 7.0 ft. below land surface measured on mo/day/yr
 Pump test data: Well water was ft. after hours pumping gpm
 Est. Yield 3.0 gpm: Well water was ft. after hours pumping gpm
 Bore Hole Diameter 8 in. to 1.20 ft., and in. to ft.
 WELL WATER TO BE USED AS: 5 Public water supply 8 Air conditioning 11 Injection well
1 Domestic 3 Feedlot 6 Oil field water supply 9 Dewatering 12 Other (Specify below)
 2 Irrigation 4 Industrial 7 Lawn and garden only 10 Observation well
 Was a chemical/bacteriological sample submitted to Department? Yes.....No..... If yes, mo/day/yr sample was submitted
 Water Well Disinfected? Yes No

5 TYPE OF BLANK CASING USED: 1 Steel 3 RMP (SR) 5 Wrought iron 8 Concrete tile CASING JOINTS: Glued Clamped
2 PVC 4 ABS 6 Asbestos-Cement 9 Other (specify below) Welded Screws
 Blank casing diameter 5 in. to 100 ft., Dia in. to ft., Dia in. to ft.
 Casing height above land surface 2 in., weight 5.4 lbs./ft. Wall thickness or gauge No.
 TYPE OF SCREEN OR PERFORATION MATERIAL: 7 PVC 10 Asbestos-cement
 1 Steel 3 Stainless steel 5 Fiberglass 8 RMP (SR) 11 Other (specify)
 2 Brass 4 Galvanized steel 6 Concrete tile 9 ABS 12 None used (open hole)
 SCREEN OR PERFORATION OPENINGS ARE: 3 Mill slot 3/1000 5 Gauzed wrapped 8 Saw cut 11 None (open hole)
 1 Continuous slot 6 Wire wrapped 9 Drilled holes
 2 Louvered shutter 4 Key punched 7 Torch cut 10 Other (specify)
 SCREEN-PERFORATED INTERVALS: From 100 ft. to 120 ft., From ft. to ft.
 GRAVEL PACK INTERVALS: From 2.5 ft. to 120 ft., From ft. to ft.

6 GROUT MATERIAL: 1 Neat cement 2 Cement grout 3 Bentonite 4 Other
 Grout Intervals: From 5 ft. to 2.5 ft., From ft. to Environment ft.
 What is the nearest source of possible contamination: None Close 10 Livestock pens 14 Abandoned water well
 1 Septic tank 4 Lateral lines 7 Pit privy 11 Fuel storage 15 Oil well/Gas well
 2 Sewer lines 5 Cess pool 8 Sewage lagoon 12 Fertilizer storage 16 Other (specify below)
 3 Watertight sewer lines 6 Seepage pit 9 Feedyard 13 Insecticide storage

Direction from well? How many feet?

FROM	TO	LITHOLOGIC LOG	FROM	TO	LITHOLOGIC LOG
0	9	Rock			
9	15	Yellow Clay			
15	27	Brown Clay			
27	37	Brown Shale			
37	47	Rock			
47	78	Grey Shale			
78	96	Rock (Water)			
96	120	Shale			

7 CONTRACTOR'S OR LANDOWNER'S CERTIFICATION: This water well was (1) constructed, (2) reconstructed, or (3) plugged under my jurisdiction and was completed on (mo/day/year) 6/10/87 and this record is true to the best of my knowledge and belief. Kansas Water Well Contractor's License No. 451 This Water Well Record was completed on (mo/day/yr) 6/23/87 under the business name of Nalden Well Drilling by (signature) Craig Hill