


1 LOCATION OF WATER WELL: County: Geary 031 Fraction: 1/4 NE 1/4 SW 1/4 Section Number: 33 Township Number: T 11 S Range Number: R 5 E/W

Distance and direction from nearest town or city street address of well if located within city? From J.C. Limits Go 1 mile west on Highway 18 Go 1 mile north on County Road + 1/2 mile east on County Road

2 WATER WELL OWNER: Scott Johnson RR#, St. Address, Box #: 285 B RT 3 City, State, ZIP Code: Junction City, Kansas 66441 Board of Agriculture, Division of Water Resources Application Number:

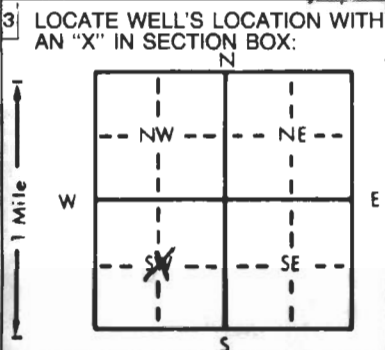

4 DEPTH OF COMPLETED WELL: 100' ft. ELEVATION: ft.
 Depth(s) Groundwater Encountered 1. 67' ft. 2. ft. 3. ft.
 WELL'S STATIC WATER LEVEL: 63' ft. below land surface measured on mo/day/yr ft.
 Pump test data: Well water was ft. after hours pumping gpm
 Est. Yield: 15 gpm Well water was ft. after hours pumping gpm
 Bore Hole Diameter: 8 in. to 100' ft., and in. to ft.
 WELL WATER TO BE USED AS:
 1 Domestic 3 Feedlot 6 Oil field water supply 9 Dewatering 12 Other (Specify below)
 2 Irrigation 4 Industrial 7 Lawn and garden only 10 Observation well
 Was a chemical/bacteriological sample submitted to Department? Yes.....No.....; If yes, mo/day/yr sample was submitted
 Water Well Disinfected? Yes No

5 TYPE OF BLANK CASING USED:
 1 Steel 3 RMP (SR) 5 Wrought iron 8 Concrete tile CASING JOINTS: Glued Clamped
 2 PVC 4 ABS 6 Asbestos-Cement 9 Other (specify below) Welded
 Blank casing diameter: 5 in. to 80' ft., Dia. in. to ft., Dia. in. to ft.
 Casing height above land surface: 2' in., weight 54.40 lbs./ft. Wall thickness or gauge No.
 TYPE OF SCREEN OR PERFORATION MATERIAL:
 1 Steel 3 Stainless steel 5 Fiberglass 7 PVC 10 Asbestos-cement
 2 Brass 4 Galvanized steel 6 Concrete tile 9 ABS 12 None used (open hole)
 SCREEN OR PERFORATION OPENINGS ARE:
 1 Continuous slot 3 Mill slot 3/1000 5 Gauzed wrapped 8 Saw cut 11 None (open hole)
 2 Louvered shutter 4 Key punched 6 Wire wrapped 9 Drilled holes
 SCREEN-PERFORATED INTERVALS: From 8.0 ft. to 100' ft., From ft. to ft.
 GRAVEL PACK INTERVALS: From 25 ft. to 100' ft., From ft. to ft.

6 GROUT MATERIAL: 1 Neat cement 2 Cement grout 3 Bentonite 4 Other
 Grout Intervals: From 0 ft. to 25 ft., From ft. to Enviroplug ft. to ft.
 What is the nearest source of possible contamination: None Close
 1 Septic tank 4 Lateral lines 7 Pit privy 10 Livestock pens 14 Abandoned water well
 2 Sewer lines 5 Cess pool 8 Sewage lagoon 11 Fuel storage 15 Oil well/Gas well
 3 Watertight sewer lines 6 Seepage pit 9 Feedyard 12 Fertilizer storage 16 Other (specify below)
 13 Insecticide storage
 Direction from well? How many feet?

FROM	TO	LITHOLOGIC LOG	FROM	TO	LITHOLOGIC LOG
0	10	Brown clay			
10	20	Yellow clay			
20	25	Brown clay			
25	44	Rock			
44	51	Grey shale			
51	57	Rock			
57	58	Grey shale			
58	61	Rock			
61	67	Grey shale			
67	76	Rock (Water)			
76	100	Grey shale & Rock			

7 CONTRACTOR'S OR LANDOWNER'S CERTIFICATION: This water well was (1) constructed, (2) reconstructed, or (3) plugged under my jurisdiction and was completed on (mo/day/year) 3/29/88 and this record is true to the best of my knowledge and belief. Kansas Water Well Contractor's License No. 451 This Water Well Record was completed on (mo/day/yr) 4/16/88 under the business name of Haldeman Well Drilling by (signature) Craig Haldeman
 INSTRUCTIONS: Use typewriter or ballpoint pen. PLEASE PRESS FIRMLY and PRINT clearly. Please fill in blanks. underline or circle the correct answers. Send top three copies to Kansas Department of Health and Environment, Bureau of Water Protection, Topeka, Kansas 66620-7320, Telephone: 913-862-9360. Send one to WATER WELL OWNER and retain one for your records.