


1 LOCATION OF WATER WELL: Fraction 1/4 SW 1/4 SW 1/4 Section Number 33 Township Number T 11 S Range Number R 5 W
 County: GEARY
 Distance and direction from nearest town or city street address of well if located within city? 1 MILE WEST OF JUNCTION CITY ON HIGHWAY 77, 1/2 MILE WEST ON 8TH STREET

2 WATER WELL OWNER: SCOTT JOHNSON
 RR#, St. Address, Box #: RR3 285B Board of Agriculture, Division of Water Resources
 City, State, ZIP Code: JUNCTION CITY KANSAS 66441 Application Number:

3 LOCATE WELL'S LOCATION WITH AN "X" IN SECTION BOX:

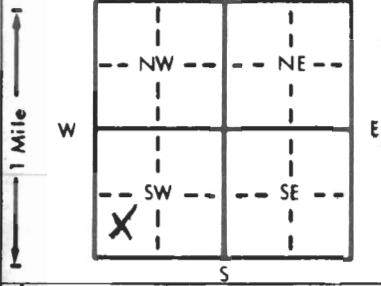

4 DEPTH OF COMPLETED WELL: 120 ft. ELEVATION:
 Depth(s) Groundwater Encountered 1. 90 ft. 2. ft. 3. ft.
 WELL'S STATIC WATER LEVEL 78 ft. below land surface measured on mo/day/yr
 Pump test data: Well water was ft. after hours pumping gpm
 Est. Yield 15 gpm: Well water was ft. after hours pumping gpm
 Bore Hole Diameter 8 in. to 120 ft., and in. to ft.
 WELL WATER TO BE USED AS: 5 Public water supply 8 Air conditioning 11 Injection well
1 Domestic 3 Feedlot 6 Oil field water supply 9 Dewatering 12 Other (Specify below)
 2 Irrigation 4 Industrial 7 Lawn and garden only 10 Monitoring well
 Was a chemical/bacteriological sample submitted to Department? Yes.....No. X.....; If yes, mo/day/yr sample was submitted
 Water Well Disinfected? Yes No

5 TYPE OF BLANK CASING USED: 5 Wrought iron 8 Concrete tile CASING JOINTS: Glued SCREENED Clamped
 1 Steel 3 RMP (SR) 6 Asbestos-Cement 9 Other (specify below) Welded
2 PVC 4 ABS 7 Fiberglass Threaded

Blank casing diameter 5 in. to 100 ft., Dia. in. to ft., Dia. in. to ft.
 Casing height above land surface 36 in., weight SCH. 40 lbs./ft. Wall thickness or gauge No.

TYPE OF SCREEN OR PERFORATION MATERIAL: 7 PVC 10 Asbestos-cement
 1 Steel 3 Stainless steel 5 Fiberglass 8 RMP (SR) 11 Other (specify)
 2 Brass 4 Galvanized steel 6 Concrete tile 9 ABS 12 None used (open hole)

SCREEN OR PERFORATION OPENINGS ARE: 5 Gauzed wrapped 8 Saw cut 11 None (open hole)
 1 Continuous slot 3 Mill slot 31/1000 6 Wire wrapped 9 Drilled holes
 2 Louvered shutter 4 Key punched 7 Torch cut 10 Other (specify)

SCREEN-PERFORATED INTERVALS: From 100 ft. to 120 ft., From ft. to ft.
 From ft. to ft., From ft. to ft.
 GRAVEL PACK INTERVALS: From 20 ft. to 120 ft., From ft. to ft.
 From ft. to ft., From ft. to ft.

6 GROUT MATERIAL: 1 Neat cement 2 Cement grout 3 Bentonite 4 Other
 Grout Intervals: From 0 ft. to 20 ft., From ft. to ft., From ft. to ft.

What is the nearest source of possible contamination: NONE CLOSE 10 Livestock pens 14 Abandoned water well
 1 Septic tank 4 Lateral lines 7 Pit privy 11 Fuel storage 15 Oil well/Gas well
 2 Sewer lines 5 Cess pool 8 Sewage lagoon 12 Fertilizer storage 16 Other (specify below)
 3 Watertight sewer lines 6 Seepage pit 9 Feedyard 13 Insecticide storage NONE

Direction from well? How many feet?

FROM	TO	LITHOLOGIC LOG	FROM	TO	PLUGGING INTERVALS
0	6	BROWN CLAY			
6	18	YELLOW SHALE			
18	20	GREENISH SHALE			
20	31	GREY SHALE			
31	47	YELLOW SHALE			
47	50	LIME STONE			
50	54	GREY SHALE			
54	69	LIME STONE			
69	73	GREY SHALE			
73	75	LIME STONE			
75	78	GREY SHALE			
78	100	LIME STONE			
100	120	GREY SHALE			

7 CONTRACTOR'S OR LANDOWNER'S CERTIFICATION: This water well was 1) constructed, 2) reconstructed, or 3) plugged under my jurisdiction and was completed on (mo/day/year) 11/21/89 and this record is true to the best of my knowledge and belief. Kansas
 Water Well Contractor's License No. 451 This Water Well Record was completed on (mo/day/yr) 11/21/89
 under the business name of HALDEMAN WELL DRILLING by (signature) Craig

INSTRUCTIONS: Use typewriter or ball point pen. PLEASE PRESS FIRMLY and PRINT clearly. Please fill in blanks, underline or circle the correct answers. Send two copies to Kansas Department of Health and Environment, Bureau of Water Protection, Topeka, Kansas 66620-7320. Telephone: 913-296-5514. Send one to WATER WELL OWNER and retain one for your records.