


1 LOCATION OF WATER WELL: County: GARY CO. Fraction: NE 1/4 SW 1/4 SW 1/4 Section Number: 29 Township Number: T 11 S Range Number: R 5 E  
 Distance and direction from nearest town or city street address of well, if located within city? From J.C. Co 2 miles west on 244 spur  
77 to 244 & go 2 miles west & 1/4 north on 244 spur

2 WATER WELL OWNER: Ron Stewart  
 RR#, St. Address, Box #: 1013 South Madison Board of Agriculture, Division of Water Resources  
 City, State, ZIP Code: J.C. Mo 66441 Application Number:

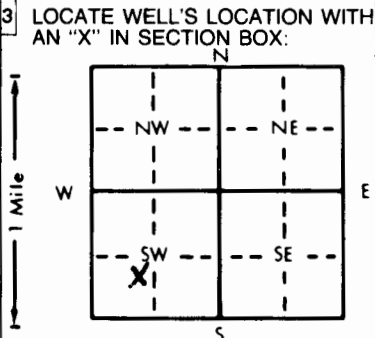

4 DEPTH OF COMPLETED WELL: 120 ft. ELEVATION:  
 Depth(s) Groundwater Encountered 1. 65 ft. 2. ft. 3. ft.  
 WELL'S STATIC WATER LEVEL: 50 ft. below land surface measured on mo/day/yr  
 Pump test data: Well water was ft. after hours pumping gpm  
 Est. Yield: 4.5 x 5 gpm: Well water was ft. after hours pumping gpm  
 Bore Hole Diameter: 7 in. to 120 in. to in. to ft.  
 WELL WATER TO BE USED AS:  
 1 Domestic  3 Feedlot  6 Oil field water supply  9 Dewatering  12 Other (Specify below)  
 2 Irrigation  4 Industrial  7 Lawn and garden only  10 Monitoring well  
 Was a chemical/bacteriological sample submitted to Department? Yes  No  If yes, mo/day/yr sample was submitted

5 TYPE OF BLANK CASING USED:  
 1 Steel  3 RMP (SR)  5 Wrought iron  8 Concrete tile  CASING JOINTS:  Glued  Clamped  
 2 PVC  4 ABS  6 Asbestos-Cement  9 Other (specify below)  Welded  
 5 1/2 in.  7 Fiberglass  Threaded  
 Blank casing diameter: 5 1/2 in. to 100 ft., Dia. in. to ft., Dia. in. to ft.  
 Casing height above land surface: 2 in., weight 564.40 lbs./ft. Wall thickness or gauge No.  
 TYPE OF SCREEN OR PERFORATION MATERIAL:  
 1 Steel  3 Stainless steel  5 Fiberglass  7 PVC  10 Asbestos-cement  
 2 Brass  4 Galvanized steel  6 Concrete tile  9 ABS  11 Other (specify)  
 SCREEN OR PERFORATION OPENINGS ARE:  
 1 Continuous slot  3 Mill slot 25/100's  5 Gauzed wrapped  8 Saw cut  11 None (open hole)  
 2 Louvered shutter  4 Key punched  6 Wire wrapped  9 Drilled holes  
 7 Torch cut  10 Other (specify)  
 SCREEN-PERFORATED INTERVALS: From 100 ft. to 120 ft., From ft. to ft.  
 GRAVEL PACK INTERVALS: From 25 ft. to 120 ft., From ft. to ft.

6 GROUT MATERIAL:  1 Neat cement  2 Cement grout  3 Bentonite  4 Other  
 Grout Intervals: From 0 ft. to 25 ft., From ft. to ft., From ft. to ft.  
 What is the nearest source of possible contamination: None Close  
 1 Septic tank  4 Lateral lines  7 Pit privy  10 Livestock pens  14 Abandoned water well  
 2 Sewer lines  5 Cess pool  8 Sewage lagoon  11 Fuel storage  15 Oil well/Gas well  
 3 Watertight sewer lines  6 Seepage pit  9 Feedyard  12 Fertilizer storage  16 Other (specify below)  
 13 Insecticide storage

Direction from well? How many feet?

FROM	TO	LITHOLOGIC LOG	FROM	TO	PLUGGING INTERVALS
0	1	Top Soil			
1	11	Brown Clay			
11	27	Yellow Shale			
27	45	Brown Shale			
45	58	Limestone (Water)			
58	65	Grey Shale			
65	70	Limestone			
70	84	Tan Shale			
84	102	Limestone			
102	120	Grey Shale			

7 CONTRACTOR'S OR LANDOWNER'S CERTIFICATION: This water well was  (1) constructed,  (2) reconstructed, or  (3) plugged under my jurisdiction and was completed on (mo/day/year) 11/11/97 and this record is true to the best of my knowledge and belief. Kansas Water Well Contractor's License No. 451 This Water Well Record was completed on (mo/day/yr) 12/25/98 under the business name of Halderman Well Drilling by (signature) Craig V. Cohn/PE

OFFICE USE ONLY