


1 LOCATION OF WATER WELL: County: Geary Fraction: NE 1/4 SE 1/4 NW 1/4 Section Number: 15 Township Number: T 11 S Range Number: R 5 E/W

Distance and direction from nearest town or city street address of well if located within city?
FROM Junction City go 3 miles north on 77 and 1/4 east

2 WATER WELL OWNER: Roger Houston
 RR#, St. Address, Box #: 724 Rock Ledge Board of Agriculture, Division of Water Resources
 City, State, ZIP Code: Junction City, Ks, 66441 Application Number:

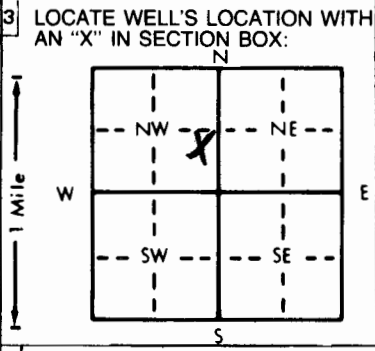

4 DEPTH OF COMPLETED WELL: 120 ft. ELEVATION:
 Depth(s) Groundwater Encountered 1. 75 ft. 2. ft. 3. ft.
 WELL'S STATIC WATER LEVEL 20 ft. below land surface measured on mo/day/yr
 Pump test data: Well water was ft. after hours pumping gpm
 Est. Yield 15 gpm Well water was ft. after hours pumping gpm
 Bore Hole Diameter 9 in. to 120 in. to in. to ft.
 WELL WATER TO BE USED AS: 5 Public water supply 8 Air conditioning 11 Injection well
 Domestic 3 Feedlot 6 Oil field water supply 9 Dewatering 12 Other (Specify below)
 2 Irrigation 4 Industrial 7 Lawn and garden only 10 Monitoring well
 Was a chemical/bacteriological sample submitted to Department? Yes.....No..... If yes, mo/day/yr sample was sub-
 mitted Water Well Disinfected Yes No

5 TYPE OF BLANK CASING USED: 5 Wrought iron 8 Concrete tile CASING JOINTS: Glued Clamped
 1 Steel PVC 3 RMP (SR) 6 Asbestos-Cement 9 Other (specify below) Welded
 4 ABS 7 Fiberglass Threaded
 Blank casing diameter 5 in. to 100 ft. Dia in. to ft. Dia in. to ft.
 Casing height above land surface 2 ft in., weight Sch. 40 lbs./ft. Wall thickness or gauge No.
 TYPE OF SCREEN OR PERFORATION MATERIAL: 7 PVC 10 Asbestos-cement
 1 Steel 3 Stainless steel 5 Fiberglass 8 RMP (SR) 11 Other (specify)
 2 Brass 4 Galvanized steel 6 Concrete tile 9 ABS 12 None used (open hole)
 SCREEN OR PERFORATION OPENINGS ARE: 25/1000 5 Gauzed wrapped 8 Saw cut 11 None (open hole)
 1 Continuous slot 3 Mill slot 6 Wire wrapped 9 Drilled holes
 2 Louvered shutter 4 Key punched 7 Torch cut 10 Other (specify)
 SCREEN-PERFORATED INTERVALS: From 100 ft. to 120 ft. From ft. to ft.
 From ft. to ft. From ft. to ft.
 GRAVEL PACK INTERVALS: From 25 ft. to 120 ft. From ft. to ft.
 From ft. to ft. From ft. to ft.

6 GROUT MATERIAL: 1 Neat cement 2 Cement grout Bentonite 4 Other
 Grout intervals: From 0 ft. to 25 ft., From ft. to ft., From ft. to ft.
 What is the nearest source of possible contamination: None close
 1 Septic tank 4 Lateral lines 7 Pit privy 10 Livestock pens 14 Abandoned water well
 2 Sewer lines 5 Cess pool 8 Sewage lagoon 11 Fuel storage 15 Oil well/Gas well
 3 Watertight sewer lines 6 Seepage pit 9 Feedyard 12 Fertilizer storage 16 Other (specify below)
 13 Insecticide storage
 Direction from well? How many feet?

FROM	TO	LITHOLOGIC LOG	FROM	TO	PLUGGING INTERVALS
0	1	Top Soil	103	111	Greenish Shale
1	2	Yellow Shale	111	120	Dark Brown Shale
2	5	Limestone			
5	18	Yellow Shale			
18	22	Limestone			
22	37	Greenish Shale			
37	39	Limestone			
39	46	Brown Shale			
46	53	Limestone			
53	64	Greenish Shale			
64	71	Limestone			
71	75	Gray shale			
75	84	Limestone			
84	87	Greenish Shale			
87	103	Limestone			

7 CONTRACTOR'S OR LANDOWNER'S CERTIFICATION: This water well was (1) constructed, (2) reconstructed, or (3) plugged under my jurisdiction and was completed on (mo/day/year) 8/4/98 and this record is true to the best of my knowledge and belief. Kansas Water Well Contractor's License No. 451 This Water Well Record was completed on (mo/day/yr) 9/12/98 under the business name of Holdiman Well Drilling by (signature) Craig CUDPT

OFFICE USE ONLY T R E/W SEC. 1/4 1/4 1/4