


1	LOCATION OF WATER WELL:	Fraction	Section Number	Township Number	Range Number
	County: <u>Geary</u>	<u>SE ¼ NW ¼ SE ¼</u>	<u>35</u>	<u>11 S</u>	<u>5</u> E/W

Distance and direction from nearest town or city street address of well if located within city?
E. of Hwy 57 / N. of City Water Plant

2	WATER WELL OWNER: <u>Republican River Industrial Park</u>	Board of Agriculture, Division of Water Resources
	RR #, St. Address, Box #: <u>P.O. Box 1876</u>	Application Number:
	City, State, ZIP Code: <u>Junction City, KS 66441</u>	

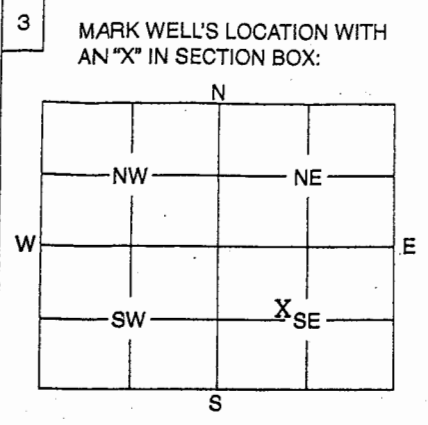

4	DEPTH OF WELL <u>18</u> ft.												
	WELL'S STATIC WATER LEVEL <u>Dry</u> ft.												
	WELL WAS USED AS:												
	<table border="0"> <tr> <td>1 Domestic</td> <td>5 Public Water Supply</td> <td>9 Dewatering</td> </tr> <tr> <td>2 Irrigation</td> <td>6 Oil Field Water Supply</td> <td>10 Monitoring Well</td> </tr> <tr> <td>3 Feedlot</td> <td>7 Domestic (Lawn & Garden)</td> <td>11 Injection Well</td> </tr> <tr> <td>4 Industrial</td> <td>8 Air Conditioning</td> <td>12 Other</td> </tr> </table>	1 Domestic	5 Public Water Supply	9 Dewatering	2 Irrigation	6 Oil Field Water Supply	10 Monitoring Well	3 Feedlot	7 Domestic (Lawn & Garden)	11 Injection Well	4 Industrial	8 Air Conditioning	12 Other
1 Domestic	5 Public Water Supply	9 Dewatering											
2 Irrigation	6 Oil Field Water Supply	10 Monitoring Well											
3 Feedlot	7 Domestic (Lawn & Garden)	11 Injection Well											
4 Industrial	8 Air Conditioning	12 Other											
	Was a chemical / bacteriological sample submitted to Department? Yes No <u>...X...</u>												
	If yes, mo/day/yr sample was submitted												
	Water Well Disinfected: Yes No <u>...X...</u>												

5	TYPE OF BLANK CASING USED:										
	<table border="0"> <tr> <td>1 Steel</td> <td>3 RMP (SR)</td> <td>5 Wrought</td> <td>7 Fiberglass</td> <td>9 Other (Specify below)</td> </tr> <tr> <td>2 PVC</td> <td>4 ABS</td> <td>6 Asbestos-Cement</td> <td>8 Concrete Tile</td> <td></td> </tr> </table>	1 Steel	3 RMP (SR)	5 Wrought	7 Fiberglass	9 Other (Specify below)	2 PVC	4 ABS	6 Asbestos-Cement	8 Concrete Tile	
1 Steel	3 RMP (SR)	5 Wrought	7 Fiberglass	9 Other (Specify below)							
2 PVC	4 ABS	6 Asbestos-Cement	8 Concrete Tile								
	Blank casing diameter <u>2</u> in. Was casing pulled? Yes No <u>...X...</u>										
	Casing height above or below land surface <u>n/a</u> in. Drilled out to <u>18'</u> if yes, how much										

6	GROUT PLUG MATERIAL: 1 Neat cement 2 Cement grout 3 Bentonite 4 Other <u>Concrete</u>																				
	Grout Plug Intervals: From <u>0</u> ft. to <u>2</u> ft., From <u>2</u> ft. to <u>18</u> ft., From to ft.																				
	What is the nearest source of possible contamination:																				
	<table border="0"> <tr> <td>1 Septic tank</td> <td>6 Seepage pit</td> <td>11 Fuel storage</td> <td>13 Other (specify below)</td> </tr> <tr> <td>2 Sewer lines</td> <td>7 Pit privy</td> <td>12 Fertilizer storage</td> <td><u>13 Other (specify below)</u></td> </tr> <tr> <td>3 Watertight sewer lines</td> <td>8 Sewage lagoon</td> <td>13 Insecticide storage</td> <td><u>13 Other (specify below)</u></td> </tr> <tr> <td>4 Lateral lines</td> <td>9 Feedyard</td> <td>14 Abandoned water well</td> <td><u>13 Other (specify below)</u></td> </tr> <tr> <td>5 Cess pool</td> <td>10 Livestock pens</td> <td>15 Oil well/Gas well</td> <td><u>13 Other (specify below)</u></td> </tr> </table>	1 Septic tank	6 Seepage pit	11 Fuel storage	13 Other (specify below)	2 Sewer lines	7 Pit privy	12 Fertilizer storage	<u>13 Other (specify below)</u>	3 Watertight sewer lines	8 Sewage lagoon	13 Insecticide storage	<u>13 Other (specify below)</u>	4 Lateral lines	9 Feedyard	14 Abandoned water well	<u>13 Other (specify below)</u>	5 Cess pool	10 Livestock pens	15 Oil well/Gas well	<u>13 Other (specify below)</u>
1 Septic tank	6 Seepage pit	11 Fuel storage	13 Other (specify below)																		
2 Sewer lines	7 Pit privy	12 Fertilizer storage	<u>13 Other (specify below)</u>																		
3 Watertight sewer lines	8 Sewage lagoon	13 Insecticide storage	<u>13 Other (specify below)</u>																		
4 Lateral lines	9 Feedyard	14 Abandoned water well	<u>13 Other (specify below)</u>																		
5 Cess pool	10 Livestock pens	15 Oil well/Gas well	<u>13 Other (specify below)</u>																		
	Direction from well? How many feet?																				

FROM	TO	PLUGGING MATERIALS
<u>0</u>	<u>2</u>	<u>Concrete (8")</u>
<u>2</u>	<u>18</u>	<u>Bentonite (8")</u>

VOBW-1

KDHE # US 031 00590
GC # 1201

7	CONTRACTOR'S OF LANDOWNER'S CERTIFICATION: This water well was plugged under my jurisdiction and was completed on (mo/day/year) <u>1/5/2005</u> and this record is true to the best of my knowledge and belief. Kansas Water Well Contractor's License No. <u>527</u> This Water Well Record was completed on (mo/day/year) <u>1/25/2005</u> under the business name of <u>GeoCore, Inc.</u> by (signature) <u>[Signature]</u>
---	--

INSTRUCTIONS: Use typewriter or ball point pen. Please press firmly and print clearly. Please fill in blanks, underline or circle the correct answers. Send top three copies to Kansas Department of Health and Environment, Bureau of Water, Geology Section, 1000 SW Jackson St., Ste. 420, Topeka, Kansas 66612-1367. Telephone: 785/296-5522. Send one to Water Well Owner and retain one for your records.