

CORRECTION(S) TO WATER WELL RECORD (WWC-5)

(to rectify lacking or incorrect information)

Location listed as:

Section-Township-Range: None Given

Fraction ($\frac{1}{4}$ $\frac{1}{4}$ $\frac{1}{4}$): _____

County: Geary

Location changed to:

25-11S-5E

SE NW NE

Other changes: Initial statements: Riley County

Changed to: Geary County

Comments: Section, Township, Range, and quarters were determined by projecting normal Public Land Survey System over Ft. Riley.

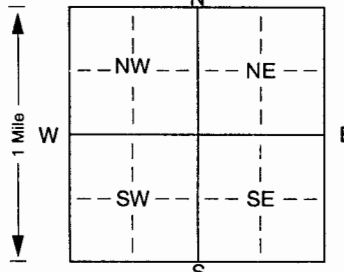
verification method: Latitude and longitude, and Junction City 1:24,000 topo. map.

initials: ORL date: 4/26/2006

1 LOCATION OF WATER WELL: Fraction $\frac{1}{4}$ $\frac{1}{4}$ $\frac{1}{4}$ Section Number Township Number Range Number
 County: Riley T S R EW

Distance and direction from nearest town or city street address of well if located within city?
Lat/Long. 39°04'15.337"N 96°49'10.856"W

2 WATER WELL OWNER: Ft Riley Directorate of Environment & Safety
 RR#, St. Address, Box #: Bldg 407 Pershing Ct Board of Agriculture, Division of Water Resources
 City, State, ZIP Code: Ft Riley KS Application Number:

3 LOCATE WELL'S LOCATION WITH AN "X" IN SECTION BOX:


4 DEPTH OF COMPLETED WELL: 94.1 ft. ELEVATION:
 Depth(s) Groundwater Encountered 1. ft. 2. ft. 3. ft.
 WELL'S STATIC WATER LEVEL: 34.8 ft. below land surface measured on mo/day/yr 2/13/06
 Pump test data: Well water was ft. after hours pumping gpm
 Est. Yield gpm: Well water was ft. after hours pumping gpm
 Bore Hole Diameter: in. to ft., and in. to ft.
 WELL WATER TO BE USED AS: 5 Public water supply 8 Air conditioning 11 Injection well
 1 Domestic 3 Feedlot 6 Oil field water supply 9 Dewatering 12 Other (Specify below)
 2 Irrigation 4 Industrial 7 Domestic (lawn & garden) 10 Monitoring well Observation well
 Was a chemical/bacteriological sample submitted to Department? Yes. No. ; If yes, mo/day/yr sample was sub-
 mitted Water Well Disinfected? Yes No

5 TYPE OF BLANK CASING USED:
 1 Steel 3 RMP (SR) 5 Wrought iron 8 Concrete tile CASING JOINTS: Glued. Clamped.
 2 PVC 4 ABS 6 Asbestos-Cement 9 Other (specify below) Welded
 7 Fiberglass Pulled 4.4 Threaded
 Blank casing diameter 2 in. to ft., Dia in. to ft., Dia in. to ft.
 Casing height below above land surface. 3.2 ft weight lbs./ft. Wall thickness or gauge No.
 TYPE OF SCREEN OR PERFORATION MATERIAL:
 1 Steel 3 Stainless steel 5 Fiberglass 7 PVC 10 Asbestos-cement
 2 Brass 4 Galvanized steel 6 Concrete tile 8 RMP (SR) 11 Other (specify)
 9 ABS 12 None used (open hole)
 SCREEN OR PERFORATION OPENINGS ARE:
 1 Continuous slot 3 Mill slot 5 Gauzed wrapped 8 Saw cut 11 None (open hole)
 2 Louvered shutter 4 Key punched 6 Wire wrapped 9 Drilled holes
 7 Torch cut 10 Other (specify) ft.
 SCREEN-PERFORATED INTERVALS: From ft. to ft., From ft. to ft.
 From ft. to ft., From ft. to ft.
 GRAVEL PACK INTERVALS: From ft. to ft., From ft. to ft.
 From ft. to ft., From ft. to ft.

6 GROUT MATERIAL: 1 Neat cement 2 Cement grout 3 Bentonite 4 Other 5% Bentonite Cement Grout
 Grout Intervals: From 94.1 ft. to 3.2 ft., From ft. to ft., From ft. to ft.
 What is the nearest source of possible contamination:
 1 Septic tank 4 Lateral lines 7 Pit privy 10 Livestock pens 14 Abandoned water well
 2 Sewer lines 5 Cess pool 8 Sewage lagoon 11 Fuel storage 15 Oil well/Gas well
 3 Watertight sewer lines 6 Seepage pit 9 Feedyard 12 Fertilizer storage 13 Insecticide storage 16 Other (specify below)
 Direction from well? W How many feet? 50 Water Well Bldg. 3/A8

FROM	TO	LITHOLOGIC LOG	FROM	TO	PLUGGING INTERVALS
			<u>94.1</u>	<u>3.2</u>	<u>5% Bentonite Cement Grout</u>
			<u>3.2</u>	<u>0</u>	<u>Topsoil</u>

7 CONTRACTOR'S OR LANDOWNER'S CERTIFICATION: This water well was (1) constructed, (2) reconstructed, or (3) plugged under my jurisdiction and was completed on (mo/day/year) 2/14/06 and this record is true to the best of my knowledge and belief. Kansas Water Well Contractor's Licence No. This Water Well Record was completed on (mo/day/yr) 2/22/06 under the business name of USACE by (signature) [Signature]