

CORRECTION(S) TO WATER WELL RECORD (WWC-5)
(to rectify lacking or incorrect information)

County: Geary

Location listed as:

Location ~~changed to~~:

Section-Township-Range: _____

29-11S-5E

Fraction ($\frac{1}{4}$ $\frac{1}{4}$ $\frac{1}{4}$): _____

SE SW SE SE

Other changes: Initial statements: Public Water Supply Well

Changed to: Domestic Well

Comments: Well is approx. 2 mi. W. of Junction City on Hwy 18, then 2 mi. N.

verification method: Phone call to well contractor, latitude & longitude & KGS' "LEO" conversion tool, and mapping tool on KGS website. initials: BRK date: 9/15/2011

submitted by: Kansas Geological Survey, Data Resources Library, 1930 Constant Ave., Lawrence, KS 66047-3726
to: Kansas Dept of Health & Environment, Bureau of Water, 1000 SW Jackson, Suite 420, Topeka, KS 66612-1367.

WATER WELL RECORD


Form WWC-5

Division of Water Resources App. No.

1 LOCATION OF WATER WELL: Fraction SW 1/4 SE 1/4 SE 1/4 1/4 Section Number 29 Township No. T 11 S Range Number R 5 E W
 County: Geary

Street/Rural Address of Well Location; if unknown, distance & direction from nearest town or intersection: If at owner's address, check here **Global Positioning System (GPS) information:**
 Latitude: 39.05992 (in decimal degrees)
 Longitude: 96.89079 (in decimal degrees)
 Elevation: 1237
 Datum: WGS 84, NAD 83, NAD 27
 Collection Method: GPS unit (Make/Model: Garmin ETREX)
 Digital Map/Photo, Topographic Map, Land Survey
 Est. Accuracy: <3 m, 3-5 m, 5-15 m, >15 m

2 WATER WELL OWNER: Shelby Richling
 RR#, Street Address, Box #: 1004 Kingbury Rd
 City, State, ZIP Code: Junction City, KS 66441

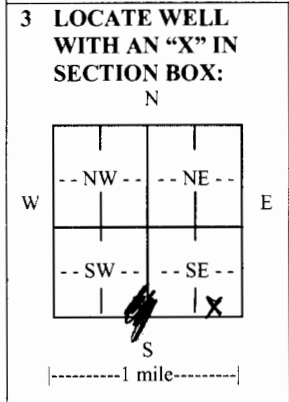

4 DEPTH OF COMPLETED WELL 120 ft.
 Depth(s) Groundwater Encountered (1) 50 ft. (2) 100 ft. (3)..... ft.
 WELL'S STATIC WATER LEVEL 71 ft. below land surface measured on mo/day/yr. 7/21/11
 Pump test data: Well water was.....ft. after..... hours pumping..... gpm
 EST. YIELD 20 gpm. Well water was.....ft. after..... hours pumping..... gpm
 Bore Hole Diameter 10 in. to 120 ft., and.....in. to.....ft.
 WELL WATER TO BE USED AS: Public water supply Geothermal Injection well
 Domestic Feedlot Oil field water supply Dewatering Other (Specify below)
 Irrigation Industrial Domestic-lawn & garden Monitoring well
 Was a chemical/bacteriological sample submitted to Department? Yes No
 If yes, mo/day/yr sample was submitted.....
 Water well disinfected? Yes No

5 TYPE OF CASING USED: Steel PVC Other.....
 CASING JOINTS: Glued Clamped Welded Threaded
 Casing diameter 6 in. to 120 ft., Diameter.....in. to.....ft., Diameter.....in. to.....ft.
 Casing height above land surface 24 in., Weight.....lbs./ft., Wall thickness or gauge No.
 TYPE OF SCREEN OR PERFORATION MATERIAL:
 Steel Stainless Steel PVC Other (Specify).....
 Brass Galvanized Steel None used (open hole)
 SCREEN OR PERFORATION OPENINGS ARE:
 Continuous slot Mill slot Gauze wrapped Torch cut Drilled holes None (open hole)
 Louvered shutter Key punched Wire wrapped Saw cut Other (specify).....
 SCREEN-PERFORATED INTERVALS: From 90 ft. to 110 ft., From.....ft. to.....ft.
 GRAVEL PACK INTERVALS: From 20 ft. to 65 ft., From.....ft. to.....ft.
 From 75 ft. to 100 ft., From.....ft. to.....ft.

6 GROUT MATERIAL: Neat cement Cement grout Bentonite Other.....
 Grout Intervals: From 0 ft. to 20 ft., From 65 ft. to 75 ft., From.....ft. to.....ft.
 What is the nearest source of possible contamination:
 Septic tank Lateral lines Pit privy Livestock pens Insecticide storage Other (specify below)
 Sewer lines Cesspool Sewage lagoon Fuel storage Abandoned water well
 Watertight sewer lines Seepage pit Feedyard Fertilizer storage Oil well/gas well Pond
 Direction from well Southwest Distance from well 200 yds.

FROM	TO	LITHOLOGIC LOG	FROM	TO	LITHO. LOG (cont.) or PLUGGING INTERVALS
0	1	Topsoil			
1	7	clay			
7	14	Limestone			
14	23	weathered Limestone			
23	32	Shale			
32	35	Limestone			
35	50	Shale			
50	75	weathered Limestone			
75	85	Shale			
85	120	Limestone			

7 CONTRACTOR'S OR LANDOWNER'S CERTIFICATION: This water well was constructed, reconstructed, or plugged under my jurisdiction and was completed on (mo/day/year) 7/21/11 and this record is true to the best of my knowledge and belief.
 Kansas Water Well Contractor's License No. 710 This Water Well Record was completed on (mo/day/year) 8/2/11
 under the business name of Associated Drilling, Inc. by (signature) Taylor Howell

INSTRUCTIONS: Use typewriter or ball point pen. PLEASE PRESS FIRMLY and PRINT clearly. Please fill in blanks and check the correct answers. Send three copies (white, blue, pink) to Kansas Department of Health and Environment, Bureau of Water, Geology Section, 1000 SW Jackson St., Suite 420, Topeka, Kansas 66612-1367. Telephone 785-296-5524. Send one copy to WATER WELL OWNER and retain one for your records. Include fee of \$5.00 for each constructed well. Visit us at <http://www.kdheks.gov/waterwell/index.html>.