


AS # 1

1 LOCATION OF WATER WELL: Fraction  $\frac{1}{4}$  SE  $\frac{1}{4}$  SW  $\frac{1}{4}$  Section Number *Special 3* Township Number T 11  $\odot$  Range Number R 5  $\odot$  EW

Distance and direction from nearest town or city street address of well if located within city? *370 Grant Ave Junction City KS 66411*

2 WATER WELL OWNER: *FINA Oil & Chemical Co*  
 RR#, St. Address, Box #: *PO Box 2159* Board of Agriculture, Division of Water Resources  
 City, State, ZIP Code: *Dallas TX, 75221* Application Number:

3 LOCATE WELL'S LOCATION WITH AN "X" IN SECTION BOX:

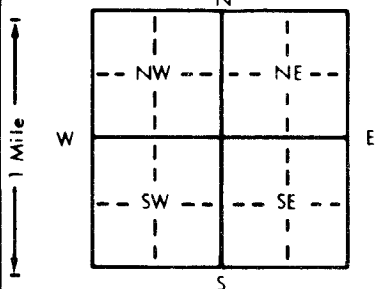

4 DEPTH OF COMPLETED WELL: *48.0* ft. ELEVATION:

Depth(s) Groundwater Encountered 1. *28.0* ft. 2. ft. 3. ft.  
 WELL'S STATIC WATER LEVEL ft. below land surface measured on mo/day/yr  
 Pump test data: Well water was ft. after hours pumping gpm  
 Est. Yield gpm: Well water was ft. after hours pumping gpm  
 Bore Hole Diameter: *7 1/4* in. to *4 8'* ft., and in. to ft.  
 WELL WATER TO BE USED AS:  
 5 Public water supply 8 Air conditioning 11 Injection well  
 1 Domestic 3 Feedlot 6 Oil field water supply 9 Dewatering 12 Other (Specify below)  
 2 Irrigation 4 Industrial 7 Lawn and garden only  Monitoring well  
 Was a chemical/bacteriological sample submitted to Department? Yes No; If yes, mo/day/yr sample was submitted  
 Water Well Disinfected? Yes No

5 TYPE OF BLANK CASING USED:  
 1 Steel 3 RMP (SR) 5 Wrought iron 8 Concrete tile CASING JOINTS: Glued Clamped  
 PVC 4 ABS 6 Asbestos-Cement 9 Other (specify below) Welded  
 7 Fiberglass Threaded

Blank casing diameter *2* in. to *46* ft. Dia. in. to ft. Dia. in. to ft.  
 Casing height above land surface in., weight lbs./ft. Wall thickness or gauge No.

TYPE OF SCREEN OR PERFORATION MATERIAL:  
 PVC 10 Asbestos-cement  
 1 Steel 3 Stainless steel 5 Fiberglass 8 RMP (SR) 11 Other (specify)  
 2 Brass 4 Galvanized steel 6 Concrete tile 9 ABS 12 None used (open hole)

SCREEN OR PERFORATION OPENINGS ARE:  
 1 Continuous slot  Mill slot 5 Gauzed wrapped 8 Saw cut 11 None (open hole)  
 2 Louvered shutter 4 Key punched 6 Wire wrapped 9 Drilled holes  
 7 Torch cut 10 Other (specify)

SCREEN-PERFORATED INTERVALS: From *48* ft. to *46* ft. From ft. to ft.  
 From ft. to ft. From ft. to ft.  
 GRAVEL PACK INTERVALS: From *48* ft. to *44* ft. From ft. to ft.  
 From ft. to ft. From ft. to ft.

6 GROUT MATERIAL: 1 Neat cement  Cement grout 3 Bentonite 4 Other  
 Grout Intervals: From *43* ft. to *50* ft. From ft. to ft. From ft. to ft.

What is the nearest source of possible contamination:  
 1 Septic tank 4 Lateral lines 7 Pit privy  Fuel storage 14 Abandoned water well  
 2 Sewer lines 5 Cess pool 8 Sewage lagoon 12 Fertilizer storage 15 Oil well/Gas well  
 3 Watertight sewer lines 6 Seepage pit 9 Feedyard 13 Insecticide storage 16 Other (specify below)

Direction from well? How many feet?

FROM	TO	LITHOLOGIC LOG	FROM	TO	PLUGGING INTERVALS
0	0.8	A asphalt			
0.8	5.0	Topsoil, Clay			
5.0	10.0	Brn. Clay			
10.0	20.0	Brn. Clay			
20.0	35.0	Brn Tan Sandy Clay			
35.0	40.0	Tan Clayey Sand			
40	48.0	Tan Brn Clay w/ M&L To Course Sand.			

7 CONTRACTOR'S OR LANDOWNER'S CERTIFICATION: This water well was  constructed, (2) reconstructed, or (3) plugged under my jurisdiction and was completed on (mo/day/year) *6-29-94* and this record is true to the best of my knowledge and belief. Kansas Water Well Contractor's License No. *575* This Water Well Record was completed on (mo/day/yr) *7-25-94* under the business name of *Kurtz Environmental Service* by (signature) *[Signature]*