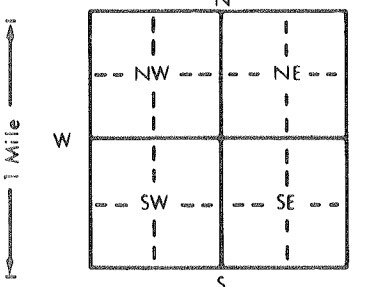


1 LOCATION OF WATER WELL: County: Geary Fraction: \*See Below Section Number: 28 Township Number: T 11 S Range Number: R 6 E

Distance and direction from nearest town or city street address of well if located within city?  
On B St. Between 5th & 6th St. Camp Funston, Ft. Riley, KS Bldg. 1539 MW94-4

2 WATER WELL OWNER: U.S. Army Corps of Engineers  
 RR#, St. Address, Box #: 601 East 12th St. Board of Agriculture, Division of Water Resource  
 City, State, ZIP Code: Kansas City, MO 64106 Application Number:

3 LOCATE WELL'S LOCATION WITH AN "X" IN SECTION BOX:  
  
 4 DEPTH OF COMPLETED WELL: 32.5 ft. ELEVATION:  
 Depth(s) Groundwater Encountered 1. 24 ft. 2. ft. 3. ft.  
 WELL'S STATIC WATER LEVEL ft. below land surface measured on mo/day/yr  
 Pump test data: Well water was ft. after hours pumping gpm  
 Est. Yield gpm: Well water was ft. after hours pumping gpm  
 Bore Hole Diameter 10.5 in. to 34 ft., and in. to ft.  
 WELL WATER TO BE USED AS:  
 5 Public water supply 8 Air conditioning 11 Injection well  
 1 Domestic 3 Feedlot 6 Oil field water supply 9 Dewatering 12 Other (Specify below)  
 2 Irrigation 4 Industrial 7 Lawn and garden only 10 Monitoring well  
 Was a chemical/bacteriological sample submitted to Department? Yes.....No...X.....; If yes, mo/day/yr sample was submitted  
 Water Well Disinfected? Yes No X

5 TYPE OF BLANK CASING USED:  
 1 Steel 3 RMP (SR) 5 Wrought iron 8 Concrete tile CASING JOINTS: Glued Clamped  
2 PVC 4 ABS 6 Asbestos-Cement 9 Other (specify below) Welded  
 7 Fiberglass Threaded X  
 Blank casing diameter 2 in. to 16.5 ft. Dia in. to ft. Dia in. to ft.  
 Casing height above land surface 1.5 in., weight Steel Flush-Mount Cover lbs./ft. Wall thickness or gauge No. Sch 40  
 TYPE OF SCREEN OR PERFORATION MATERIAL:  
 1 Steel 3 Stainless steel 5 Fiberglass 7 PVC 10 Asbestos-cement  
 2 Brass 4 Galvanized steel 6 Concrete tile 8 RMP (SR) 11 Other (specify)  
 9 ABS 12 None used (open hole)  
 SCREEN OR PERFORATION OPENINGS ARE:  
 1 Continuous slot 3 Mill slot 5 Gauzed wrapped 8 Saw cut 11 None (open hole)  
 2 Louvered shutter 4 Key punched 6 Wire wrapped 9 Drilled holes  
 7 Torch cut 10 Other (specify)  
 SCREEN-PERFORATED INTERVALS: From 31.5 ft. to 16.5 ft. From ft. to ft.  
 From ft. to ft. From ft. to ft.  
 GRAVEL PACK INTERVALS: From 34 ft. to 14.5 ft. From ft. to ft.  
 From ft. to ft. From ft. to ft.

6 GROUT MATERIAL: 1 Neat cement 2 Cement grout 3 Bentonite 4 Other Bentonite Slurry 14.5'-7.5'  
 Grout Intervals: From 7.5 ft. to 3.5 ft. From ft. to Concrete ft. From 3 ft. to 0 ft.  
 What is the nearest source of possible contamination:  
 1 Septic tank 4 Lateral lines 7 Pit privy 10 Livestock pens 14 Abandoned water well  
 2 Sewer lines 5 Cess pool 8 Sewage lagoon 11 Fuel storage 15 Oil well/Gas well  
 3 Watertight sewer lines 6 Seepage pit 9 Feedyard 12 Fertilizer storage 16 Other (specify below)  
 13 Insecticide storage UST Site  
 Direction from well? How many feet?

FROM	TO	LITHOLOGIC LOG	FROM	TO	PLUGGING INTERVALS
0	2	Gravel			
2	6	Brown Silty Clay			
6	20	Brown Silty Clay with Sand			
20	24	Gray Brown Silty Fine Sand			
24	27	Brown Fine to Medium Sand			
27	33.5	Gray Fine to Medium Sand			
33.5	34	Gray Silty Clay			
* Location Referenced to Ft. Riley Datum					
280,027 N.					
2,359,013 E.					
1056.6 Elev.					

7 CONTRACTOR'S OR LANDOWNER'S CERTIFICATION: This water well was 1 constructed, (2) reconstructed, or (3) plugged under my jurisdiction and was completed on (mo/day/year) 12/14/94 and this record is true to the best of my knowledge and belief. Kansas Water Well Contractor's License No. 510 This Water Well Record was completed on (mo/day/yr) 4/26/95 under the business name of MIKON Corporation by (signature) David Kream