


1 LOCATION OF WATER WELL: Fraction *See Below Section Number Township Number Range Number
 County: Govey SW $\frac{1}{4}$ SW $\frac{1}{4}$ SW $\frac{1}{4}$ 28 T 11 S R 6 EW

Distance and direction from nearest town or city street address of well if located within city?
 On B St. Between 5th & 6th St. Camp Funston, Ft. Riley, KS Bldg. 1539 MW95-5

2 WATER WELL OWNER: U.S. Army Corps of Engineers
 RR#, St. Address, Box #: 601 East 12th St. Board of Agriculture, Division of Water Resource
 City, State, ZIP Code: Kansas City, MO 64106 Application Number:

3 LOCATE WELL'S LOCATION WITH AN "X" IN SECTION BOX:

4 DEPTH OF COMPLETED WELL... 32.5... ft. ELEVATION: ...

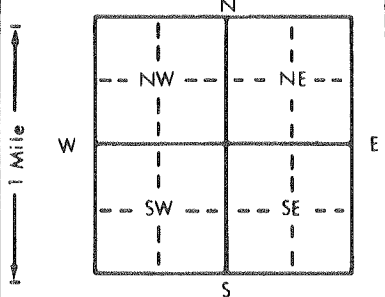

Depth(s) Groundwater Encountered 1. 25... ft. 2. ... ft. 3. ... ft.
 WELL'S STATIC WATER LEVEL ... ft. below land surface measured on mo/day/yr
 Pump test data: Well water was ... ft. after ... hours pumping ... gpm
 Est. Yield ... gpm: Well water was ... ft. after ... hours pumping ... gpm
 Bore Hole Diameter 10.5... in. to 34.5... ft., and ... in. to ... ft.
 WELL WATER TO BE USED AS: 5 Public water supply 8 Air conditioning 11 Injection well
 1 Domestic 3 Feedlot 6 Oil field water supply 9 Dewatering 12 Other (Specify below)
 2 Irrigation 4 Industrial 7 Lawn and garden only 10 Monitoring well
 Was a chemical/bacteriological sample submitted to Department? Yes... No... X...; If yes, mo/day/yr sample was submitted
 Water Well Disinfected? Yes No X

5 TYPE OF BLANK CASING USED: 5 Wrought iron 8 Concrete tile CASING JOINTS: Glued ... Clamped ...
 1 Steel 3 RMP (SR) 6 Asbestos-Cement 9 Other (specify below) Welded ...
 2 PVC 4 ABS 7 Fiberglass ... Threaded... X...
 Blank casing diameter ... 2... in. to 17.5... ft., Dia ... in. to ... ft., Dia ... in. to ... ft.
 Casing height above land surface ... 1.5... in., weight Steel Flush-Mount Cover ft. Wall thickness or gauge No. Sch 40

TYPE OF SCREEN OR PERFORATION MATERIAL: 7 PVC 10 Asbestos-cement
 1 Steel 3 Stainless steel 5 Fiberglass 8 RMP (SR) 11 Other (specify) ...
 2 Brass 4 Galvanized steel 6 Concrete tile 9 ABS 12 None used (open hole)

SCREEN OR PERFORATION OPENINGS ARE: 5 Gauzed wrapped 8 Saw cut 11 None (open hole)
 1 Continuous slot 3 Mill slot 6 Wire wrapped 9 Drilled holes
 2 Louvered shutter 4 Key punched 7 Torch cut 10 Other (specify) ...

SCREEN-PERFORATED INTERVALS: From ... 32.5... ft. to ... 17.5... ft., From ... ft. to ... ft.
 GRAVEL PACK INTERVALS: From ... 34.5... ft. to ... 13.1... ft., From ... ft. to ... ft.

6 GROUT MATERIAL: 1 Neat cement 2 Cement grout 3 Bentonite 4 Other Bentonite Slurry 13.1'-10.3'
 Grout Intervals: From ... 10.3... ft. to ... 3... ft., From ... ft. to Concrete ft., From ... 3... ft. to ... 0... ft.

What is the nearest source of possible contamination:
 1 Septic tank 4 Lateral lines 7 Pit privy 10 Livestock pens 14 Abandoned water well
 2 Sewer lines 5 Cess pool 8 Sewage lagoon 11 Fuel storage 15 Oil well/Gas well
 3 Watertight sewer lines 6 Seepage pit 9 Feedyard 12 Fertilizer storage 16 Other (specify below) UST Site
 13 Insecticide storage

Direction from well? How many feet?

FROM	TO	LITHOLOGIC LOG	FROM	TO	PLUGGING INTERVALS
0	2.5	Gravel			
2.5	10.5	Dark Brown Silty Clay			
10.5	26	Brown Silty Clay			
26	31	Dark Gray Silty Clay			
31	34.5	Dark Gray Coarse Sand			
* Location Referenced to Ft. Riley Datum					
279,954 N.					
2,358,462 E					
1056.9 Elev.					

7 CONTRACTOR'S OR LANDOWNER'S CERTIFICATION: This water well was (1) constructed, (2) reconstructed, or (3) plugged under my jurisdiction and was completed on (mo/day/year) ... 2/14/95 ... and this record is true to the best of my knowledge and belief. Kansas Water Well Contractor's License No. ... 510 ... This Water Well Record was completed on (mo/day/yr) ... 4/26/95 ... under the business name of MIKON Corporation by (signature) David Kramer