


1 LOCATION OF WATER WELL: County: Geary Fraction: SW 1/4 SW 1/4 SW 1/4 \* See Below Section Number: 18 Township Number: T 11 S Range Number: R 6 E

Distance and direction from nearest town or city street address of well if located within city?  
One Block East of Pershing Ave. on Dickman Ave. Ft. Riley, KS Bldg. 388 MW95-6

2 WATER WELL OWNER: U.S. Army Corps of Engineers  
 RR#, St. Address, Box #: 601 East 12th St. Board of Agriculture, Division of Water Resources  
 City, State, ZIP Code: Kansas City, MO 64106 Application Number:

3 LOCATE WELL'S LOCATION WITH AN "X" IN SECTION BOX:

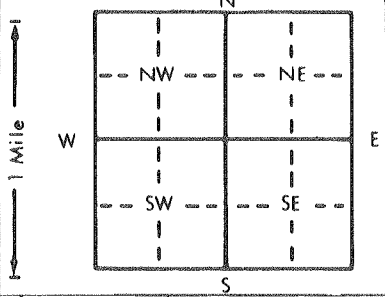

4 DEPTH OF COMPLETED WELL: 17.5 ft. ELEVATION:  
 Depth(s) Groundwater Encountered 1. 14 ft. 2. ft. 3. ft.  
 WELL'S STATIC WATER LEVEL ft. below land surface measured on mo/day/yr  
 Pump test data: Well water was ft. after hours pumping gpm  
 Est. Yield gpm: Well water was ft. after hours pumping gpm  
 Bore Hole Diameter: 10.5 in. to 20 ft., and in. to ft.  
 WELL WATER TO BE USED AS: 5 Public water supply 8 Air conditioning 11 Injection well  
 1 Domestic 3 Feedlot 6 Oil field water supply 9 Dewatering 12 Other (Specify below)  
 2 Irrigation 4 Industrial 7 Lawn and garden only 10 Monitoring well  
 Was a chemical/bacteriological sample submitted to Department? Yes.....No...X.....; If yes, mo/day/yr sample was submitted  
 Water Well Disinfected? Yes No X

5 TYPE OF BLANK CASING USED: 1 Steel 2 PVC 3 RMP (SR) 4 ABS 5 Wrought iron 6 Asbestos-Cement 7 Fiberglass 8 Concrete tile 9 Other (specify below) CASING JOINTS: Glued Clamped Welded Threaded X

Blank casing diameter 2 in. to 7.5 ft., Dia in. to ft., Dia in. to ft.  
 Casing height above land surface 1.5 in., weight Steel Flush-Mount Cover lbs./ft. Wall thickness or gauge No. Sch 40

TYPE OF SCREEN OR PERFORATION MATERIAL: 1 Steel 2 Brass 3 Stainless steel 4 Galvanized steel 5 Fiberglass 6 Concrete tile 7 PVC 8 RMP (SR) 9 ABS 10 Asbestos-cement 11 Other (specify) 12 None used (open hole)

SCREEN OR PERFORATION OPENINGS ARE: 1 Continuous slot 2 Louvered shutter 3 Mill slot 4 Key punched 5 Gauzed wrapped 6 Wire wrapped 7 Torch cut 8 Saw cut 9 Drilled holes 10 Other (specify) 11 None (open hole)

SCREEN-PERFORATED INTERVALS: From 17.5 ft. to 7.5 ft., From ft. to ft., From ft. to ft.  
 GRAVEL PACK INTERVALS: From 20 ft. to 5.5 ft., From ft. to ft., From ft. to ft.

6 GROUT MATERIAL: 1 Neat cement 2 Cement grout 3 Bentonite 4 Other Bentonite Slurry 5.5' - 3.5'  
 Grout Intervals: From 3.5 ft. to 3 ft., From ft. to Concrete ft., From 3 ft. to 0 ft.

What is the nearest source of possible contamination:  
 1 Septic tank 2 Sewer lines 3 Watertight sewer lines 4 Lateral lines 5 Cess pool 6 Seepage pit 7 Pit privy 8 Sewage lagoon 9 Feedyard 10 Livestock pens 11 Fuel storage 12 Fertilizer storage 13 Insecticide storage 14 Abandoned water well 15 Oil well/Gas well 16 Other (specify below) UST Site

Direction from well?		LITHOLOGIC LOG	How many feet?	
FROM	TO		FROM	TO
0	1	Gravel		
1'	3.5'	Brown Silty Sandy Clay		
3.5'	15'	Brown Clayey Sand		
15'	17'	Light Brown Silty Sandy Clay		
17'	19'	Dark Gray Sale		
* Location Referenced to Ft. Riley Datum				
269,193 N. 2,348,773 E. 1077.0 Elev.				

7 CONTRACTOR'S OR LANDOWNER'S CERTIFICATION: This water well was 1 constructed, (2) reconstructed, or (3) plugged under my jurisdiction and was completed on (mo/day/year) 2/8/95 and this record is true to the best of my knowledge and belief. Kansas Water Well Contractor's License No. 510 This Water Well Record was completed on (mo/day/yr) 4/26/95 under the business name of MIKON Corporation by (signature) David Kramer