

1 LOCATION OF WATER WELL: Fraction *See below Section Number Township Number Range Number
 County: Riley NE $\frac{1}{4}$ NW $\frac{1}{4}$ SE $\frac{1}{4}$ 14 T 11 S R 06 EW

Distance and direction from nearest town or city street address of well if located within city?

Southeast corner of B St. & Second St. Camp Funston Ft. Riley, KS 1044MW-95-10

2 WATER WELL OWNER: US Army Corps of Engineers


RR#, St. Address, Box # : 601 E 12th St.

Board of Agriculture, Division of Water Resources

City, State, ZIP Code : Kansas City, MO 64106

Application Number:

3 LOCATE WELL'S LOCATION WITH AN "X" IN SECTION BOX:

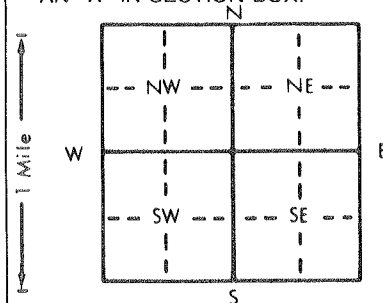

4 DEPTH OF COMPLETED WELL... 32... ft. ELEVATION: ... 1058.9237 TC.

Depth(s) Groundwater Encountered 1... 21... ft. 2... ft. 3... ft.

WELL'S STATIC WATER LEVEL ... ft. below land surface measured on mo/day/yr 9/26/95

Pump test data: Well water was ... ft. after ... hours pumping ... gpm

Est. Yield ... gpm: Well water was ... ft. after ... hours pumping ... gpm

Bore Hole Diameter ... in. to ... ft. and ... in. to ... ft.

WELL WATER TO BE USED AS: 5 Public water supply 8 Air conditioning 11 Injection well

1 Domestic 3 Feedlot 6 Oil field water supply 9 Dewatering 12 Other (Specify below)

2 Irrigation 4 Industrial 7 Lawn and garden only 10 Monitoring well

Was a chemical/bacteriological sample submitted to Department? Yes... No... If yes, mo/day/yr sample was sub

mitted Water Well Disinfected? Yes No

5 TYPE OF BLANK CASING USED:

- 1 Steel 3 RMP (SR)
 2 PVC 4 ABS

5 Wrought iron

8 Concrete tile

CASING JOINTS: Glued ... Clamped ...

6 Asbestos-Cement

9 Other (specify below)

Welded ...

7 Fiberglass

Threaded. X

Blank casing diameter ... 2... in. to ... 31.5... ft. Dia ... in. to ... ft. Dia ... in. to ... ft.

Casing height above land surface ... 2... in., weight ... Flush Mount Well Covers ... ft. Wall thickness or gauge No. SCH. 40

TYPE OF SCREEN OR PERFORATION MATERIAL:

- 1 Steel 3 Stainless steel
 2 Brass 4 Galvanized steel

5 Fiberglass

7 PVC

10 Asbestos-cement

6 Concrete tile

8 RMP (SR)

11 Other (specify)

9 ABS

12 None used (open hole)

SCREEN OR PERFORATION OPENINGS ARE:

- 1 Continuous slot 3 Mill slot
 2 Louvered shutter 4 Key punched

5 Gauzed wrapped

8 Saw cut

11 None (open hole)

6 Wire wrapped

9 Drilled holes

7 Torch cut

10 Other (specify)

SCREEN-PERFORATED INTERVALS: From ... 16... ft. to ... 31... ft. From ... ft. to ... ft.

From ... ft. to ... ft. From ... ft. to ... ft.

GRAVEL PACK INTERVALS: From ... 14... ft. to ... 31.5... ft. From ... ft. to ... ft.

From ... ft. to ... ft. From ... ft. to ... ft.

6 GROUT MATERIAL: 1 Neat cement 2 Cement grout 3 Bentonite 4 Other Concrete from surface to 3.5...

Grout Intervals: From ... 3.5... ft. to ... 11... ft. From ... 11... ft. to ... 14... ft. From ... ft. to ... ft.

What is the nearest source of possible contamination:

- 1 Septic tank 4 Lateral lines
 2 Sewer lines 5 Cess pool
 3 Watertight sewer lines 6 Seepage pit

7 Pit privy

8 Sewage lagoon

9 Feedyard

10 Livestock pens

11 Fuel storage

12 Fertilizer storage

13 Insecticide storage

14 Abandoned water well

15 Oil well/Gas well

16 Other (specify below)

UST site

Direction from well?

How many feet?

FROM	TO	LITHOLOGIC LOG	FROM	TO	PLUGGING INTERVALS
0	8"	Concrete			
8"	2'	Dark Brown Silty Clay w/Rock			
2'	28'	Brown Silty Clay			
28'	32'	Sand			
		Location referenced to Ft. Riley Datum			
		280834.07344 N			
		2357770.67071 E			
		1058.9237 Elev.			

7 CONTRACTOR'S OR LANDOWNER'S CERTIFICATION: This water well was (1) constructed, (2) reconstructed, or (3) plugged under my jurisdiction and was completed on (mo/day/year) 9/26/95 and this record is true to the best of my knowledge and belief. Kansas

Water Well Contractor's License No. 510 This Water Well Record was completed on (mo/day/yr) 1-2-96

under the business name of MIKON Corporation by (signature) David Kramer