

1 LOCATION OF WATER WELL: County: <u>Riley</u>	Fraction * See below <u>N</u> $\frac{1}{4}$ <u>NW</u> $\frac{1}{4}$ <u>SE</u> $\frac{1}{4}$ <u>14</u>	Section Number <u>14</u>	Township Number T <u>11</u> S	Range Number R <u>06</u> E <u>W</u>
---	--	-----------------------------	----------------------------------	--

Distance and direction from nearest town or city street address of well if located within city?

Southeast corner of B St. & Second St. Camp Funston Fort Riley, KS 1044MW95-7

2 WATER WELL OWNER: US Army Corps of Engineers


RR#, St. Address, Box # : 601 E 12th St.

Board of Agriculture, Division of Water Resources

City, State, ZIP Code : Kansas City, MO 64106

Application Number:

3 LOCATE WELL'S LOCATION WITH AN "X" IN SECTION BOX:

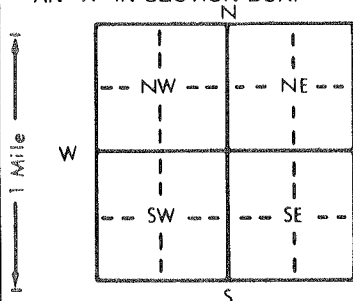

4 DEPTH OF COMPLETED WELL: 33.5 ft. ELEVATION: 1058.3878 TC

Depth(s) Groundwater Encountered 1. 25 ft. 2. ft. 3. ft.

WELL'S STATIC WATER LEVEL ft. below land surface measured on mo/day/yr 9/13/95

Pump test data: Well water was ft. after hours pumping gpm

Est. Yield gpm: Well water was ft. after hours pumping gpm

Bore Hole Diameter: 10.5 in. to 33.5 ft. and in. to ft.

WELL WATER TO BE USED AS: 5 Public water supply 8 Air conditioning 11 Injection well

1 Domestic 3 Feedlot 6 Oil field water supply 9 Dewatering 12 Other (Specify below)

2 Irrigation 4 Industrial 7 Lawn and garden only 10 Monitoring well

Was a chemical/bacteriological sample submitted to Department? Yes No; If yes, mo/day/yr sample was submitted

Water Well Disinfected? Yes No

5 TYPE OF BLANK CASING USED:

1 Steel 3 RMP (SR)

2 PVC 4 ABS

5 Wrought iron

6 Asbestos-Cement

7 Fiberglass

8 Concrete tile

9 Other (specify below)

CASING JOINTS: Glued Clamped

Welded

Threaded X

Blank casing diameter 2 in. to 32.5 ft. Dia in. to ft. Dia in. to ft.

Casing height above land surface 2 in. weight Flush Mount Cover lbs./ft. Wall thickness or gauge No. SCH 40

TYPE OF SCREEN OR PERFORATION MATERIAL:

1 Steel 3 Stainless steel

2 Brass 4 Galvanized steel

5 Fiberglass

6 Concrete tile

7 PVC

8 RMP (SR)

9 ABS

10 Asbestos-cement

11 Other (specify)

12 None used (open hole)

SCREEN OR PERFORATION OPENINGS ARE:

1 Continuous slot 3 Mill slot

2 Louvered shutter 4 Key punched

5 Gauzed wrapped

6 Wire wrapped

7 Torch cut

8 Saw cut

9 Drilled holes

10 Other (specify)

11 None (open hole)

SCREEN-PERFORATED INTERVALS: From 17 ft. to 32 ft. From ft. to ft.

From ft. to ft. From ft. to ft.

GRAVEL PACK INTERVALS: From 15 ft. to 32.5 ft. From ft. to ft.

From ft. to ft. From ft. to ft.

6 GROUT MATERIAL: 1 Neat cement 2 Cement grout 3 Bentonite 4 Other Concrete Surface to 3.5

Grout Intervals: From 3.5 ft. to 13 ft. From 13 ft. to 15 ft. From ft. to ft.

What is the nearest source of possible contamination:

1 Septic tank 4 Lateral lines

2 Sewer lines 5 Cess pool

3 Watertight sewer lines 6 Seepage pit

7 Pit privy

8 Sewage lagoon

9 Feedyard

10 Livestock pens

11 Fuel storage

12 Fertilizer storage

13 Insecticide storage

14 Abandoned water well

15 Oil well/Gas well

16 Other (specify below)

UST Site

Direction from well?

How many feet?

FROM	TO	LITHOLOGIC LOG	FROM	TO	PLUGGING INTERVALS
0	8"	Concrete			
8"	4'	Dark Brown Silty Clay w/Gravel			
4'	27'	Brown Silty Clay			
27'	30'	Sand			
		Location referenced to Ft. Riley Datum			
		280815 N			
		2357616 E			
		1058.3 Elev.			

7 CONTRACTOR'S OR LANDOWNER'S CERTIFICATION: This water well was (1) constructed, (2) reconstructed, or (3) plugged under my jurisdiction and was completed on (mo/day/year) 9/13/95 and this record is true to the best of my knowledge and belief. Kansas

Water Well Contractor's License No. 510 This Water Well Record was completed on (mo/day/yr) 1-2-95

under the business name of MIKON Corporation by (signature) David O. Kram