


1 LOCATION OF WATER WELL: County: Geary Fraction: NE 1/4 NE 1/4 NE 1/4 Section Number: 25 Township Number: T 11 S Range Number: R 6 EW

Distance and direction from nearest town or city street address of well if located within city?
Fort Riley, Kansas

2 WATER WELL OWNER: RR#, St. Address, Box # U.S. Army Corp of Engineers, Attn: Mike Greene Board of Agriculture, Division of Water Resources
City, State, ZIP Code Bldg 322, Marshall Ave., Fort Riley, Ks 66442 Application Number:

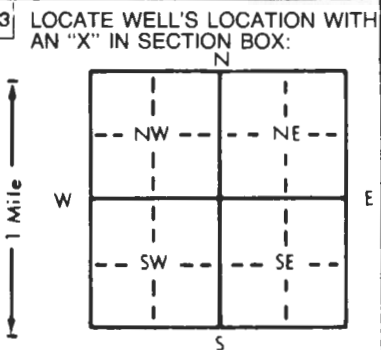

4 DEPTH OF COMPLETED WELL: 31 ft. ELEVATION: _____ ft.
Depth(s) Groundwater Encountered 1. _____ ft. 2. _____ ft. 3. _____ ft.
WELL'S STATIC WATER LEVEL: 15.7 ft. below land surface measured on mo/day/yr 5-11-96
Pump test data: Well water was _____ ft. after _____ hours pumping _____ gpm
Est. Yield _____ gpm: Well water was _____ ft. after _____ hours pumping _____ gpm
Bore Hole Diameter: 6 in. to 10 ft., and 1.32 in. to 31 ft.
WELL WATER TO BE USED AS:
5 Public water supply 8 Air conditioning 11 Injection well
1 Domestic 3 Feedlot 6 Oil field water supply 9 Dewatering 12 Other (Specify below)
2 Irrigation 4 Industrial 7 Lawn and garden only 10 Monitoring well DCF 96-25
Was a chemical/bacteriological sample submitted to Department? Yes _____ No X; If yes, mo/day/yr sample was submitted _____
Water Well Disinfected? Yes _____ No X

5 TYPE OF BLANK CASING USED:
1 Steel 3 RMP (SR) 5 Wrought iron 8 Concrete tile CASING JOINTS: Glued _____ Clamped _____
2 PVC 4 ABS 6 Asbestos-Cement 9 Other (specify below) stainless steel Welded X
7 Fiberglass Threaded _____
Blank casing diameter: 1.32 in. to 20 ft., Dia _____ in. to _____ ft., Dia _____ in. to _____ ft.
Casing height above land surface: 36 in., weight _____ lbs./ft. Wall thickness or gauge No. 27
TYPE OF SCREEN OR PERFORATION MATERIAL:
1 Steel 3 Stainless steel 5 Fiberglass 7 PVC 10 Asbestos-cement
2 Brass 4 Galvanized steel 6 Concrete tile 8 RMP (SR) 11 Other (specify) _____
9 ABS 12 None used (open hole)
SCREEN OR PERFORATION OPENINGS ARE:
1 Continuous slot 5 Gauzed wrapped 8 Saw cut 11 None (open hole)
2 Louvered shutter 3 Mill slot 6 Wire wrapped 9 Drilled holes
4 Key punched 7 Torch cut 10 Other (specify) laser cut-vert.
SCREEN-PERFORATED INTERVALS: From 20 ft. to _____ ft., From _____ ft. to _____ ft.
GRAVEL PACK INTERVALS: From _____ ft. to _____ ft., From _____ ft. to _____ ft.

6 GROUT MATERIAL: GL 1 Neat cement 2 Cement grout 3 Bentonite 4 Other _____
Grout Intervals: From GL ft. to 10 ft., From _____ ft. to _____ ft., From _____ ft. to _____ ft.
What is the nearest source of possible contamination:
1 Septic tank 4 Lateral lines 7 Pit privy 10 Livestock pens 14 Abandoned water well
2 Sewer lines 5 Cess pool 8 Sewage lagoon 11 Fuel storage 15 Oil well/Gas well
3 Watertight sewer lines 6 Seepage pit 9 Feedyard 12 Fertilizer storage 16 Other (specify below) cont. gw.
Direction from well? E-NE How many feet? 315

FROM	TO	LITHOLOGIC LOG	FROM	TO	PLUGGING INTERVALS
GL	1.00	Silt			
1.00	10.00	Silt/Fine Sand			
10.00	10.70	Silt			
10.70	13.50	med/fine sand			
13.50	31.00	unseen, unknown			
31.00	TD	End of borehole			

7 CONTRACTOR'S OR LANDOWNER'S CERTIFICATION: This water well was (1) constructed (2) reconstructed, or (3) plugged under my jurisdiction and was completed on (mo/day/year) 5/13/96 and this record is true to the best of my knowledge and belief. Kansas Water Well Contractor's License No. 479 This Water Well Record was completed on (mo/day/yr) _____ under the business name of Associated Environmental, Inc. by (signature) [Signature] 5/23/96

INSTRUCTIONS: Use typewriter or ball point pen. PLEASE PRESS FIRMLY and PRINT clearly. Please fill in blanks, underline or circle the correct answers. Send top three copies to Kansas Department of Health and Environment, Bureau of Water, Topeka, Kansas 66620-0001. Telephone: 913-296-5545. Send one to WATER WELL OWNER and retain one for your records.