

1] LOCATION OF WATER WELL: Fraction **SW ¼ SW ¼ SW ¼** Section Number **27** Township Number **T 11 S** Range Number **R 6** **(EW)**
 County: **Geary**

Distance and direction from nearest town or city street address of well if located within city?

Marshall Army Airfield - Fort Riley, KS

2] WATER WELL OWNER: **Fort Riley, DES**


RR#, St. Address, Box # : **1970 2nd St.**

Board of Agriculture, Division of Water Resources

City, State, ZIP Code : **Fort Riley, Kansas 66442-6016**

Application Number:

3] LOCATE WELL'S LOCATION WITH AN "X" IN SECTION BOX:

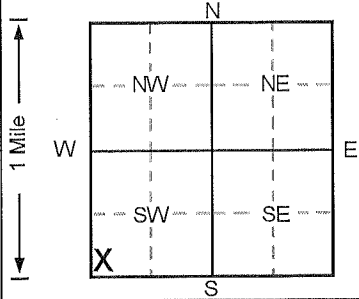

4] DEPTH OF COMPLETED WELL: **31** ft. ELEVATION: **1060**
 Depth(s) Groundwater Encountered 1. **20.2** ft. 2. ... ft. 3. ... ft.
 WELL'S STATIC WATER LEVEL: **20.2** ft. below land surface measured on mo/day/yr
 Pump test data: Well water was **NA** ft. after ... hours pumping ... gpm
 Est. Yield **NA** gpm: Well water was ... ft. after ... hours pumping ... gpm
 Bore Hole Diameter **8** in. to **31** in. to ... in. to ... ft.
 WELL WATER TO BE USED AS:
 5 Public water supply 8 Air conditioning 11 Injection well
 1 Domestic 3 Feedlot 6 Oil field water supply 9 Dewatering 12 Other (Specify below)
 2 Irrigation 4 Industrial 7 Lawn and garden only **(10) Monitoring well**
 Was a chemical/bacteriological sample submitted to Department? Yes.....No.....; If yes, mo/day/yr sample was submitted
 Water Well Disinfected? Yes No

5] TYPE OF BLANK CASING USED:

(1) Steel 3 RMP (SR) 5 Wrought iron 8 Concrete tile CASING JOINTS: Glued ... Clamped ...
 2 PVC 4 ABS 6 Asbestos-Cement 9 Other (specify below) Welded ...
 7 Fiberglass Threaded
 Blank casing diameter **2** in. to **15** in. Dia **15** ft. Dia ... ft. Dia ... in. to ... ft.
 Casing height above land surface **36** in., weight ... lbs./ft. Wall thickness or gauge No. **Sch. 40**
 TYPE OF SCREEN OR PERFORATION MATERIAL:
 1 Steel **(3) Stainless steel** 5 Fiberglass 7 PVC 10 Asbestos-cement
 2 Brass 4 Galvanized steel 6 Concrete tile 9 ABS 11 Other (specify) ...
 12 None used (open hole)
 SCREEN OR PERFORATION OPENINGS ARE:
 1 Continuous slot 3 Mill slot **(6) Wire wrapped** 8 Saw cut 11 None (open hole)
 2 Louvered shutter 4 Key punched 7 Torch cut 9 Drilled holes
 10 Other (specify) ...
 SCREEN-PERFORATED INTERVALS: From **15** ft. to **31** ft., From ... ft. to ... ft.
 GRAVEL PACK INTERVALS:
 From **Natural Formation** ft. to ... ft., From ... ft. to ... ft.

6] GROUT MATERIAL:

1 Neat cement 2 Cement grout **(3) Bentonite** 4 Other ...
 Grout Intervals: From **0** ft. to **10** ft., From ... ft. to ... ft. to ... ft.
 What is the nearest source of possible contamination:
 1 Septic tank 4 Lateral lines 7 Pit privy 10 Livestock pens 14 Abandoned water well
 2 Sewer lines 5 Cess pool 8 Sewage lagoon 11 Fuel storage 15 Oil well/Gas well
 3 Watertight sewer lines 6 Seepage pit 9 Feedyard 12 Fertilizer storage **(16) Other (specify below)**
Fire Training Pit
 Direction from well? **S** How many feet? **2000**

FROM	TO	LITHOLOGIC LOG	FROM	TO	PLUGGING INTERVALS
0	0.9	Clay, Very Dark Gray Brown			
0.9	1.4	Clay,			
1.4	4.6	Silt, Gray Brown			
4.6	5.8	Clay, Dark Gray Brown			
5.8	8.9	Silt, Gray Brown			
8.9	10	Sand, Brown			
10	31	Driven Well Point to 31 feet,			
					Driven Well Point
					FP-96-24, Abovegrade
					Project Name: Louis Berger - Ft. Riley
					GeoCore # 358, #

7] CONTRACTOR'S OR LANDOWNER'S CERTIFICATION: This water well was **(1)** constructed, (2) reconstructed, or (3) plugged under my jurisdiction and was completed on (mo/day/year) **5/20/96** and this record is true to the best of my knowledge and belief.
 Kansas Water Well Contractor's License No. **527** This Water Well Record was completed on (mo/day/yr) **6/19/96**
 under the business name of **GeoCore Services, Inc.** by (signature) *[Signature]*

INSTRUCTIONS: Use typewriter or ball point pen. PLEASE PRESS FIRMLY and PRINT clearly. Please fill in blanks, underline or circle the correct answers. Send top three copies to Kansas Department of Health and Environment, Bureau of Water, Topeka, Kansas 66620-0001. Telephone: 913-296-5545. Send one to WATER WELL OWNER and retain one for your records.

OFFICE USE ONLY
T
R
EW
SEC.
¼
¼
¼